

Charles R. Metchear, Jr.

2259 Service No. 795

Address 22 Park Road, Winchester, Mass.

Location 30 Edgewood Road

Kind of Pipe

Size

Size of Main

Repair—Renewal—New Service

Location

Date 1938	Material	Amount	Total	Date	Amount
5/9/38	2 hrs. @ 60¢	1 20	1 20	April 7, 1938	20 00
Sept 7-5-38	43' 3/4" C. Tubing @ 20¢		8 60	Deposited	
	1 3/4" S. & W.		3 75		
	1 3/4" x 1/2" Bushing		30		
			<u>13 85</u>		
	Flat Rate		\$20.00	6/24/08	credit copper outside
	Labor				

Hadley Press, Inc., Lexington

DATE March 2, 1918

TOWN OF LEXINGTON—BOARD OF PUBLIC WORKS

WATER DIVISION

The undersigned applies for a supply of water at No. 30 Edgewood Road St. and hereby agrees to comply with the rules and regulations as now, or at any future time, established by the Board of Selectmen.

Am't. of Estimate \$ _____


Owner Charles R. Metcher, Jr.

Am't. Paid \$ _____

Address 22 Park Road
Winchester, Mass.

Builder _____

Sketch of Service Here

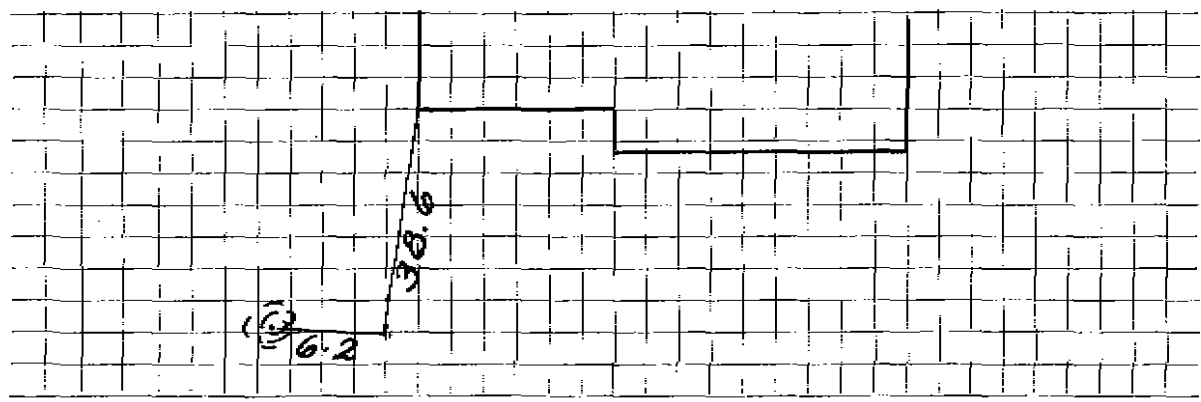

Connection made in _____ Street. Work completed _____ 19

Remarks: