


Water Service Tie Card  
**TOWN OF LEXINGTON**  
 MASSACHUSETTS

2 Edna St

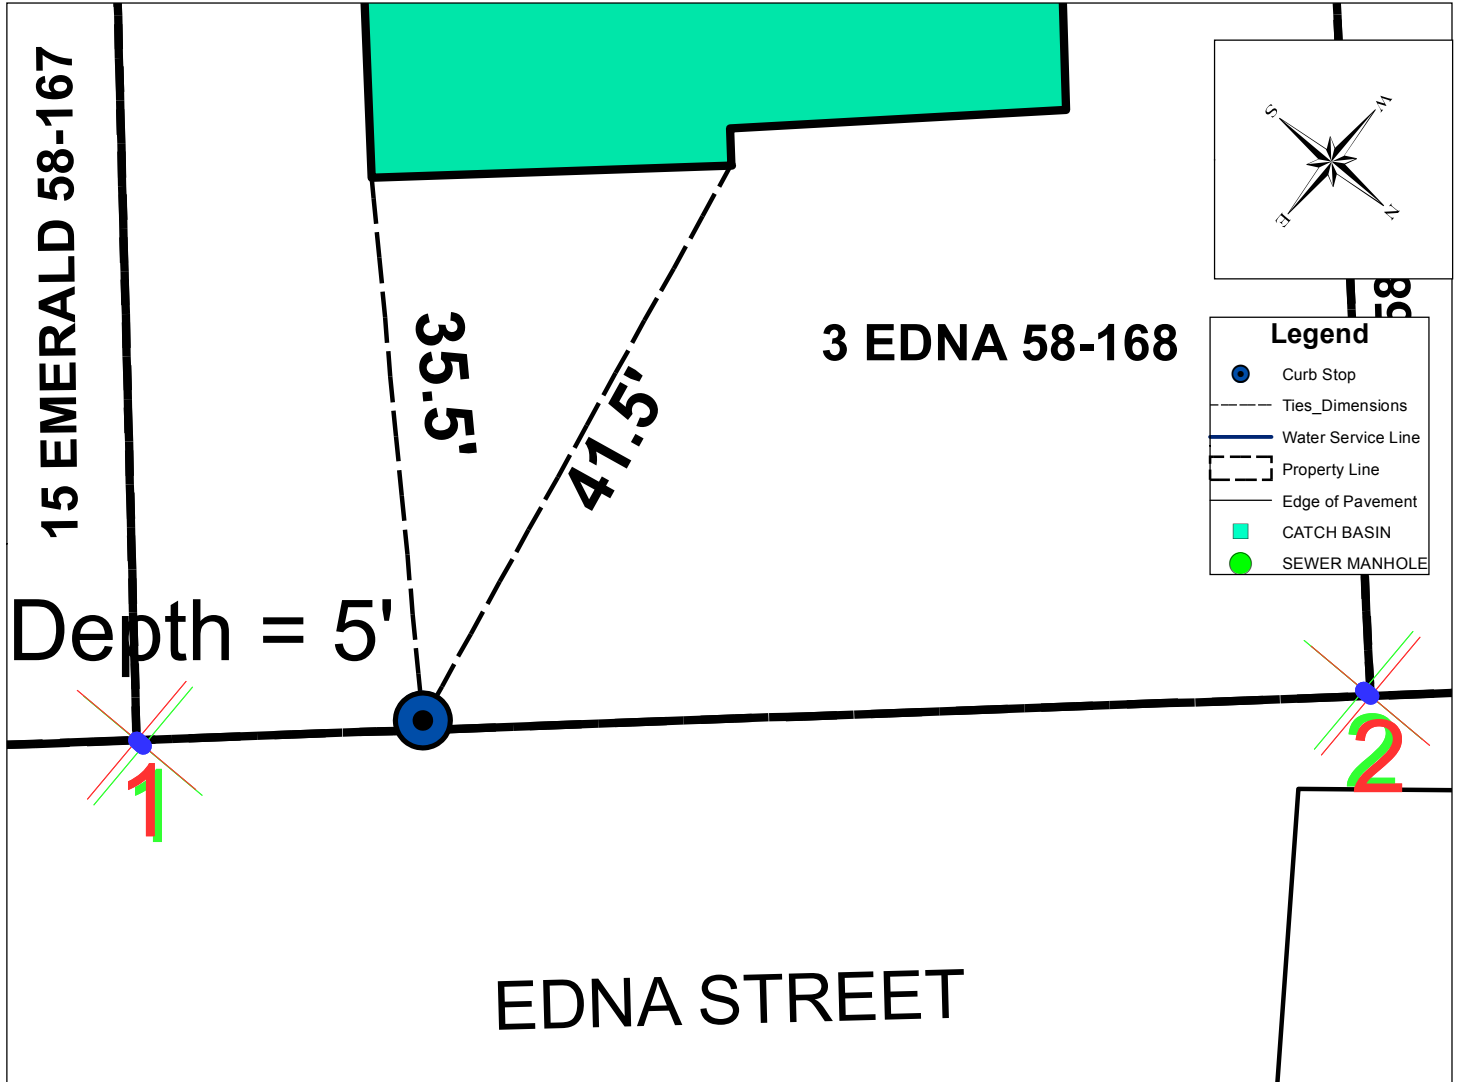

| Address   | Map and Lot        | Permit Number  | Contractor Name   | Inspector |
|---|--------------------|----------------|-------------------|-----------|
| 2 Edna St   | 58-168             |                | Iovino Excavating | msprague  |
| Date  | Material           | Depth of Cover | Amount            |           |
| 10/15/2014  | Corporation        | 5 ft           | 1                 |           |
|   | 1" Copper type "k" | 5 ft           | 15 ft ft to curb  |           |
|   | 1" Curb stop       | 5 ft           | 1                 |           |
|   | 1" Copper type "k" | 6 ft           | 36 ft ft to HSE   |           |
| <b>Type of work completed</b>                                       |                    |                |                   |           |
| New 1" water service to house from new curb stop. New house on lot. |                    |                |                   |           |