
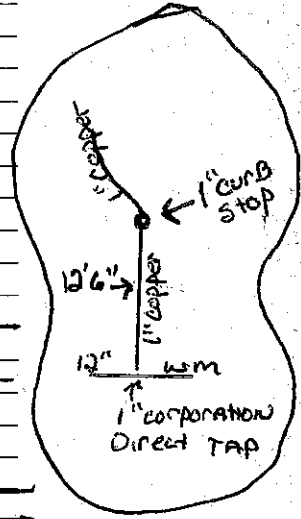


DATE 9-2-20

TOWN OF LEXINGTON — BOARD OF PUBLIC WORKS

WATER DIVISION

Sketch of Service Here

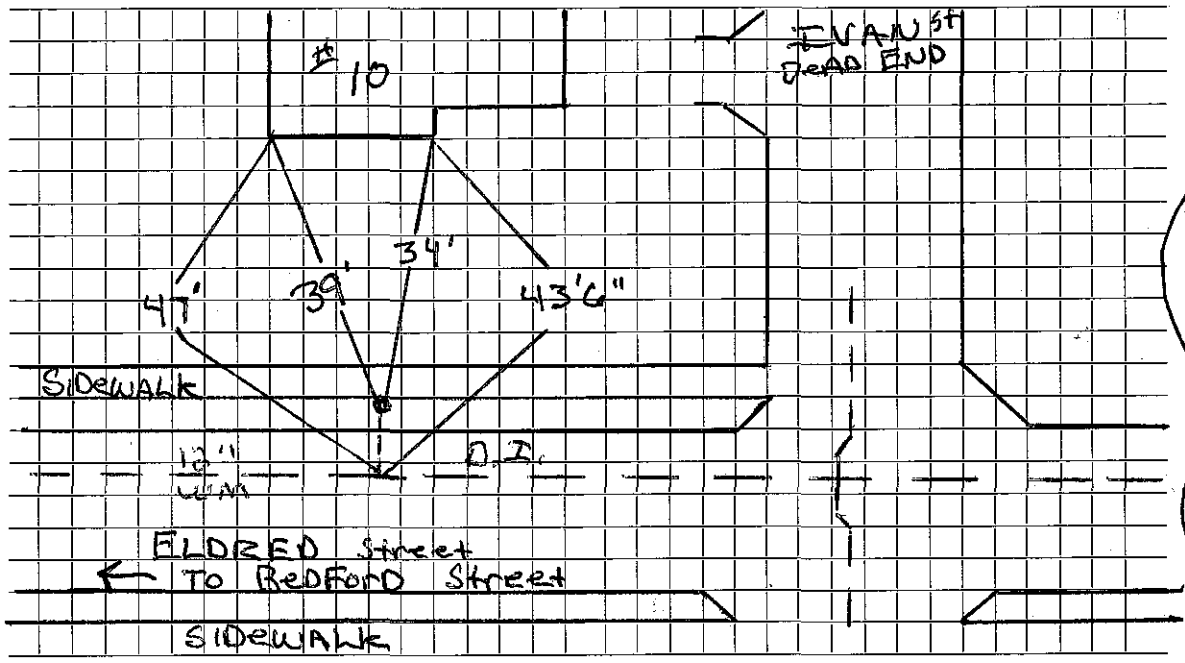

Connection made in Street.

Work completed ~~Installed~~ new main to curb stop.

Remarks:
.....
.....