

Name Joseph Frias

Service No.

Address 113 Eldred Street

Lexington, Mass.

Location 113 Eldred Street

Kind of Pipe

Size

Size of Main

~~XXXXXX~~ New Service

Com. 7-5-49

Location

Date	Material	Amount	Total	Date	Amount
May 28, '49	Labor	18 00	18 00	May 21 '49	50 00
	10% Overhead		1 80	July 6 '49	16 28
	12' - 3/4" Copper Tubing @.24		2 88		33 72
	1 - 3/4" C x 1/2" I.W.H. S&W		3 29	May 27, '49	3 20
	Shovel 1 hr. @ 7.00		7 00	28	11 97
	Trucking 1 hr. @.75		75	14' - 3/4" Copper Tubing @.24	3 36
			33 72	1 - 3/4" C Corp-cock	3 15
				1 - 3/4" C x 3/4" C Curb-cock	3 85
				2 - 3/4" C x 3/4" I Union (2pts)	1 76
				1 - Box & Rod	3 95
				2 - 1/2" Straight Tail Pieces	74
				4' - 36" Sewer Pipe	24 00
	Labor			1 - Pit Cover & Frame	8 65
				Lit lefield Shovel 1 1/2 hrs. @7.00	10 50
				Trucking 1 hr. @.75	75
					75 88

*Deposited*  
*Expended*  
Non-Charge

DATE \_\_\_\_\_

TOWN OF LEXINGTON - BOARD OF PUBLIC WORKS

**WATER DIVISION**

The undersigned applies for a supply of water at No..... St. and hereby agrees to comply with the rules and regulations as now, or at any future time, established by the Board of Selectmen.

Am't of Estimate \$.....

Owner .....


Am't Paid \$.....

Address .....

Builder .....

.....

Sketch of Service Here

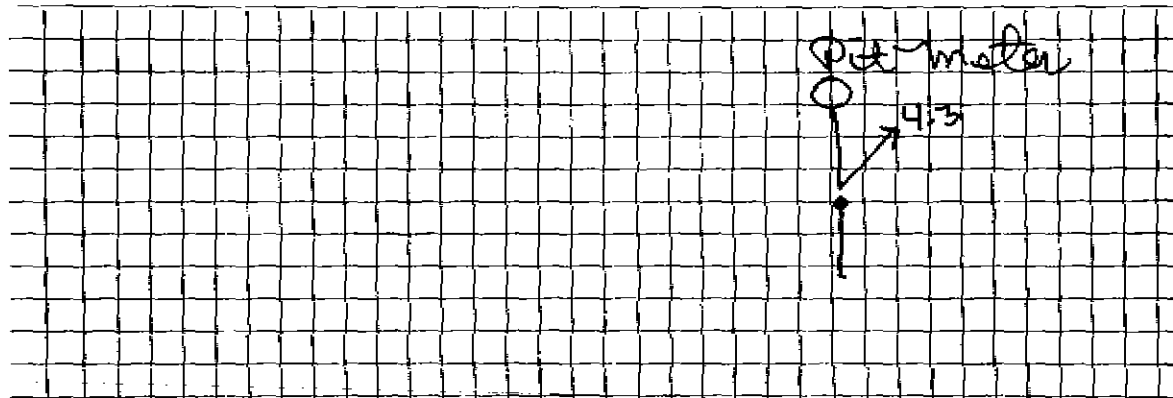

Connection made in ..... Street.

Work completed .....19

Remarks: