




DATE 8-31-20

TOWN OF LEXINGTON — BOARD OF PUBLIC WORKS

WATER DIVISION

Sketch of Service Here

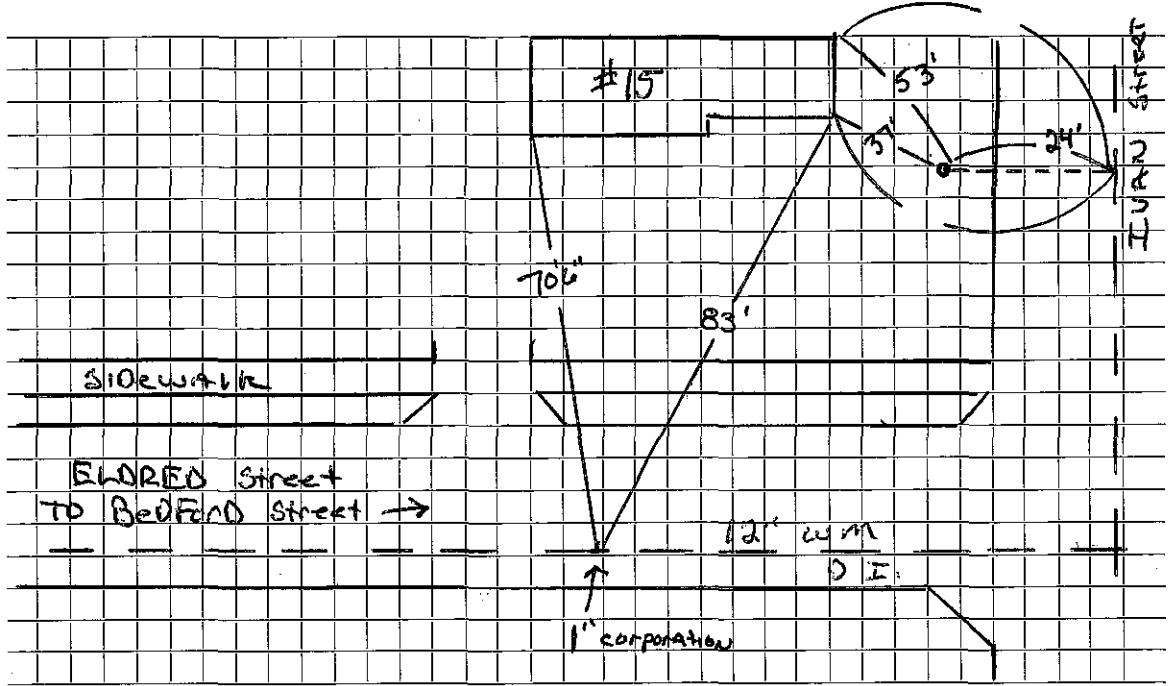

Connection made in ..... Street. Work completed .....

Remarks: Contractor installed 1" corporation w new 12" main thinking it was for 15 Elred street This house is actually serviced from Iwan st