





DATE 8-28-20

TOWN OF LEXINGTON — BOARD OF PUBLIC WORKS

WATER DIVISION

Sketch of Service Here

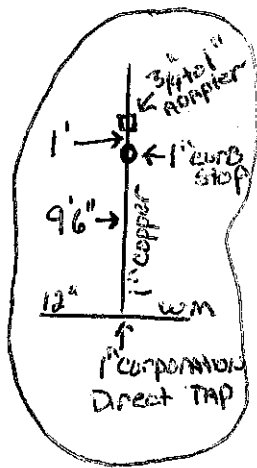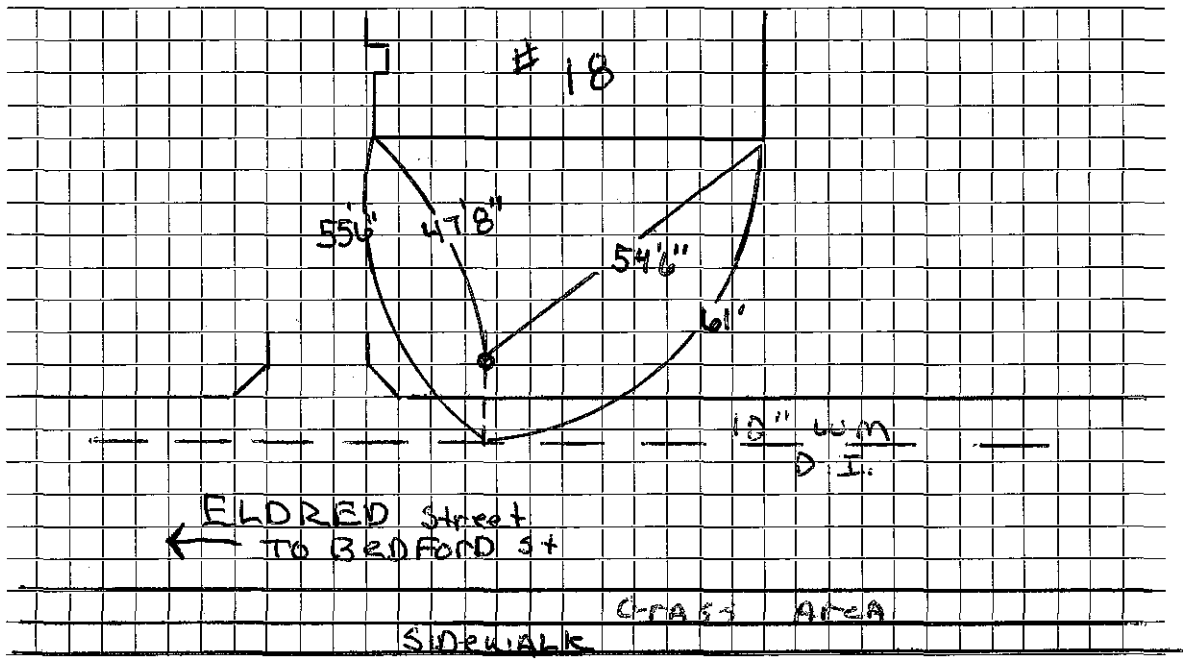

Connection made in ..... Street. Work completed INSTALLED.. New.. main.. to.. curb stop

Remarks: .....

.....

.....