





DATE 8-28-20

TOWN OF LEXINGTON — BOARD OF PUBLIC WORKS

WATER DIVISION

Sketch of Service Here

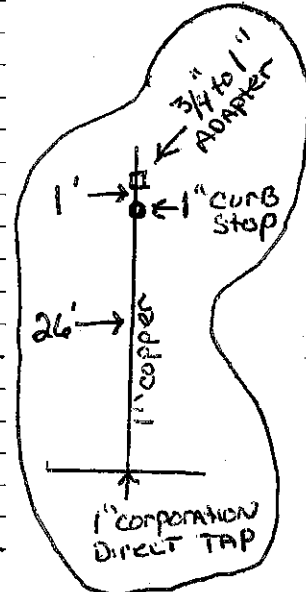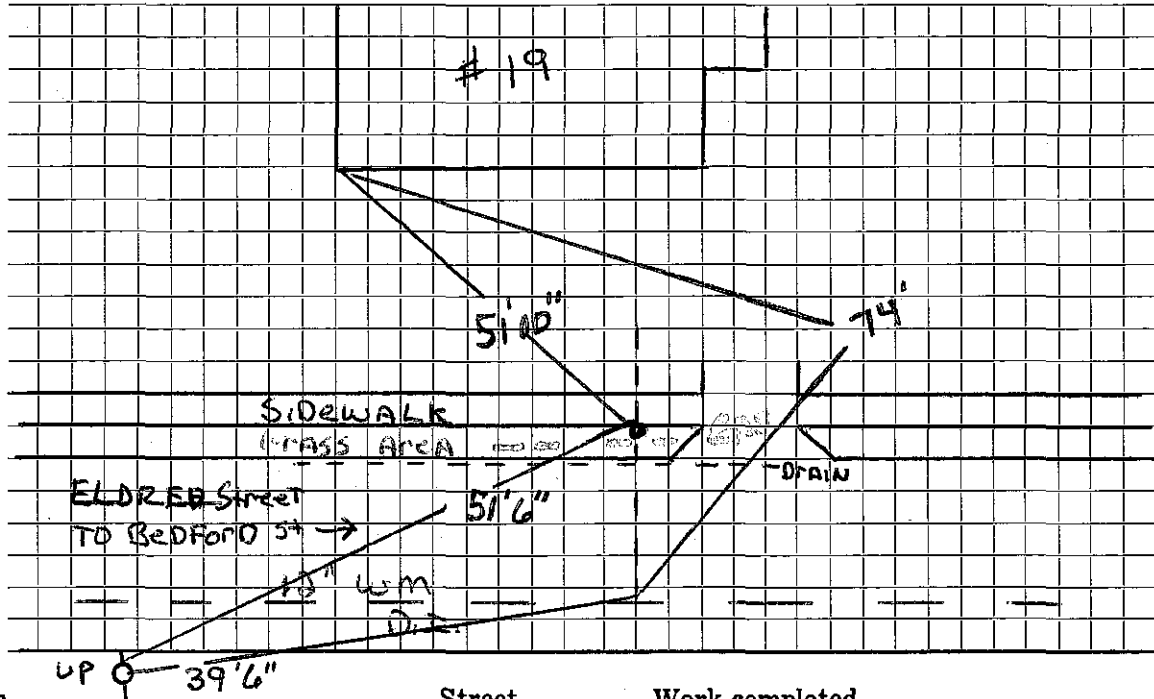

Connection made in ..... Street.

Work completed .....  
INSTALLED NEW MAIN TO CURB STOP

Remarks: .....  
.....  
.....