
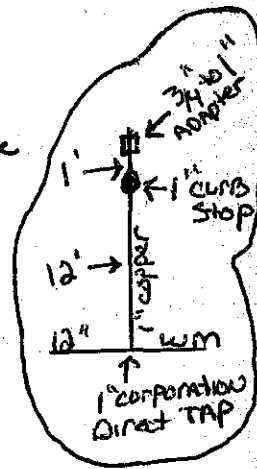


DATE 8-27-20

TOWN OF LEXINGTON — BOARD OF PUBLIC WORKS

WATER DIVISION

Sketch of Service Here

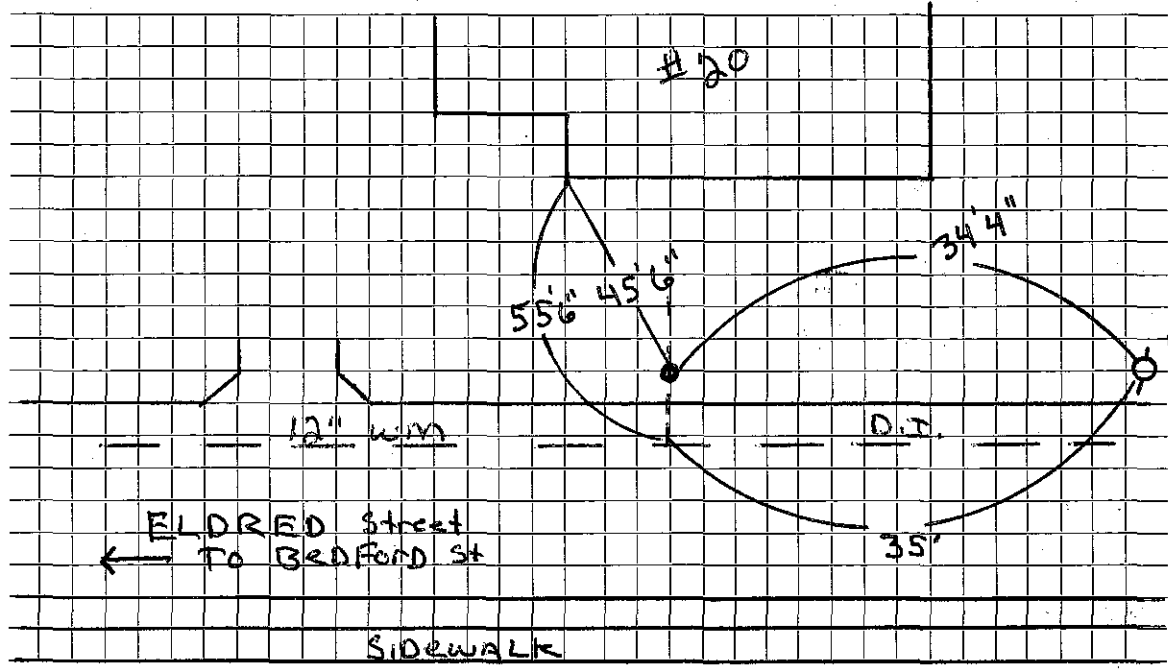

Connection made in Street.

Work completed Installed New man. to curb. Stop.

Remarks:

.....

.....