
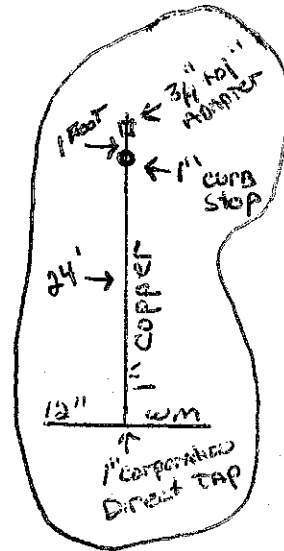


DATE 8-27-20

TOWN OF LEXINGTON — BOARD OF PUBLIC WORKS

WATER DIVISION

Sketch of Service Here

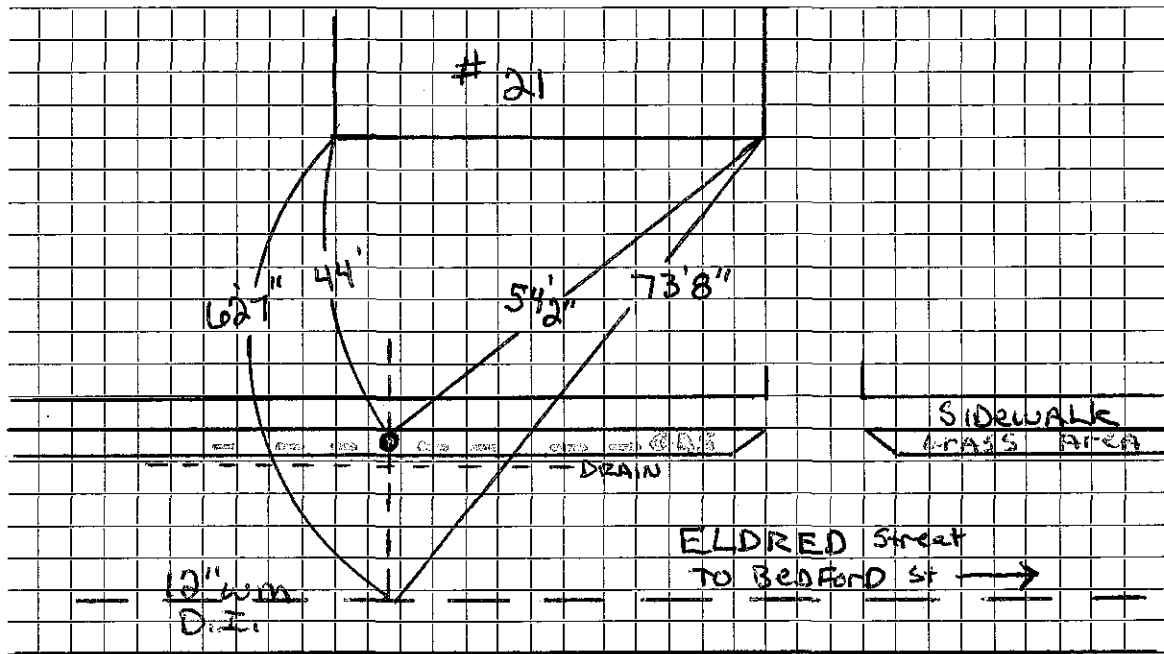

Connection made in Street. Work completed installed. new main to CURB STOP...

Remarks:.....
.....
.....