





DATE 9-2-20

TOWN OF LEXINGTON — BOARD OF PUBLIC WORKS

WATER DIVISION

Sketch of Service Here

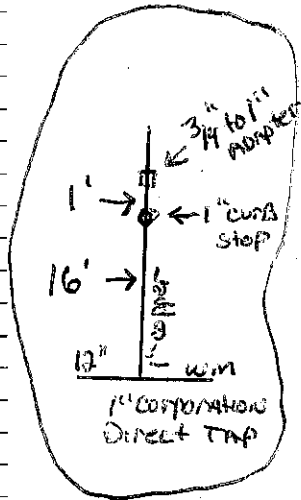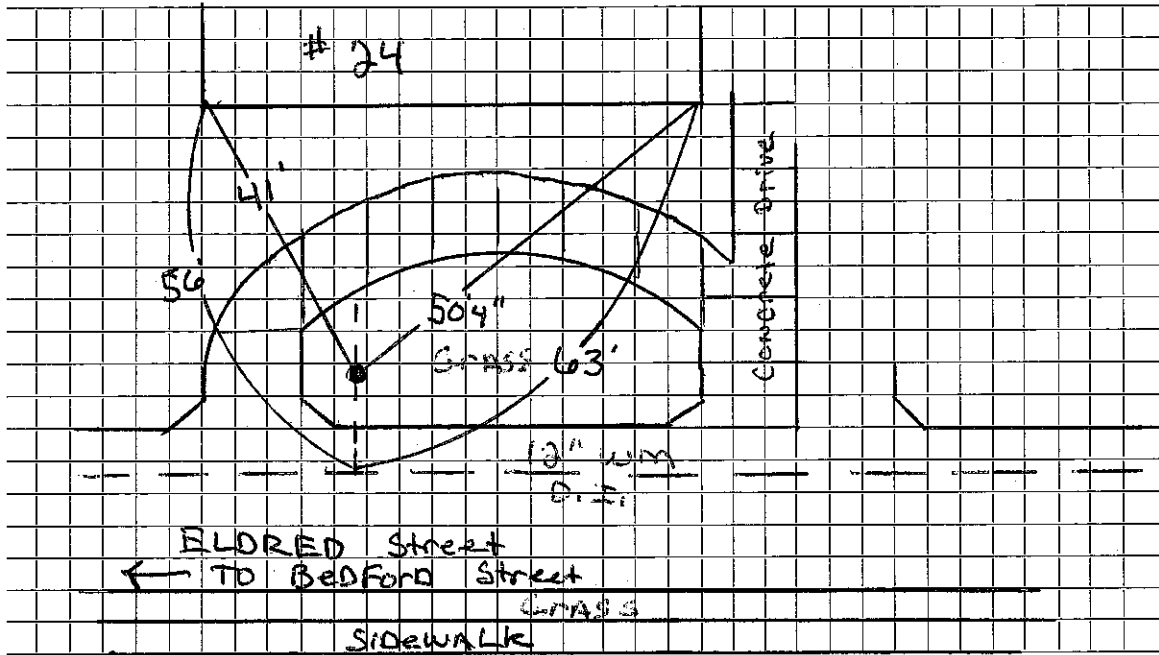

Connection made in ..... Street.

Work completed Installed new maw to curb stop.

Remarks: .....