
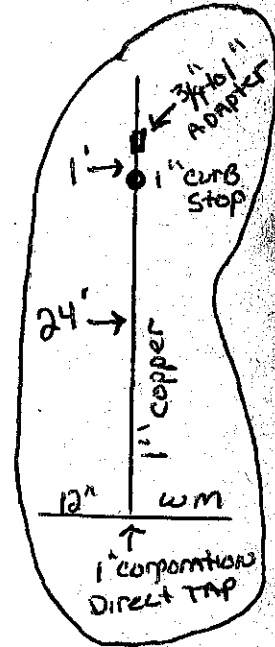


DATE 8-27-20

TOWN OF LEXINGTON — BOARD OF PUBLIC WORKS

WATER DIVISION

Sketch of Service Here

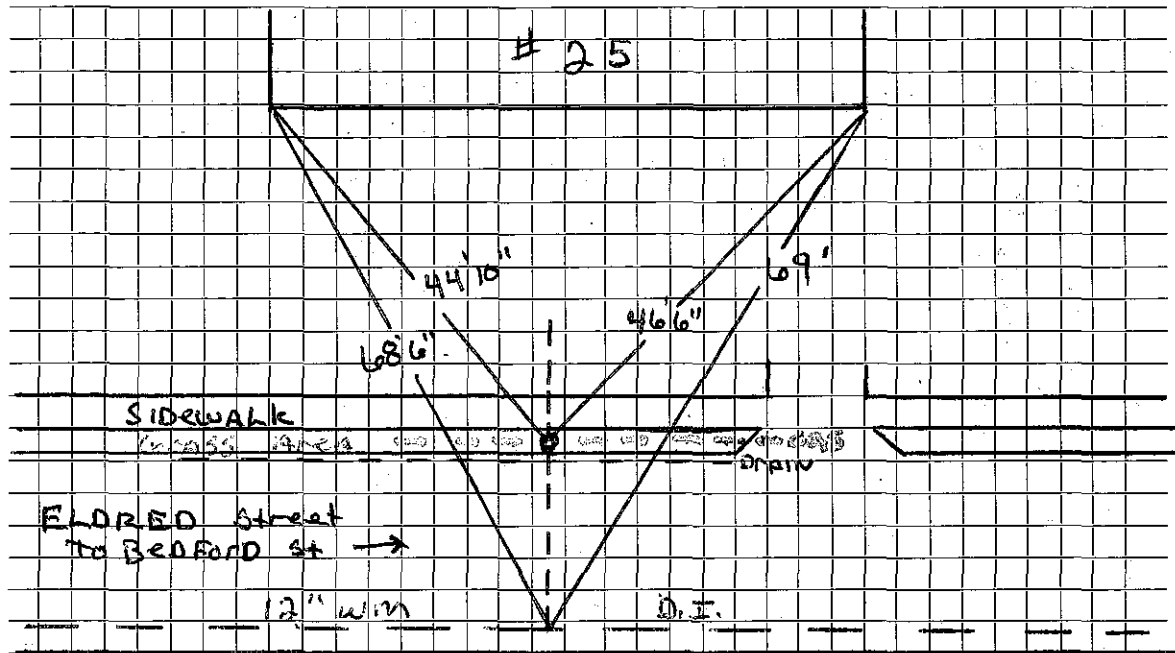

Connection made in Street. Work completed Installed. New. MAIN. TO. CURB. STOP

Remarks:

.....

.....