





DATE 8-26-20

TOWN OF LEXINGTON — BOARD OF PUBLIC WORKS

WATER DIVISION

Sketch of Service Here

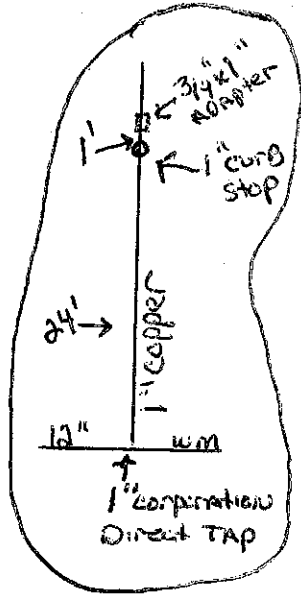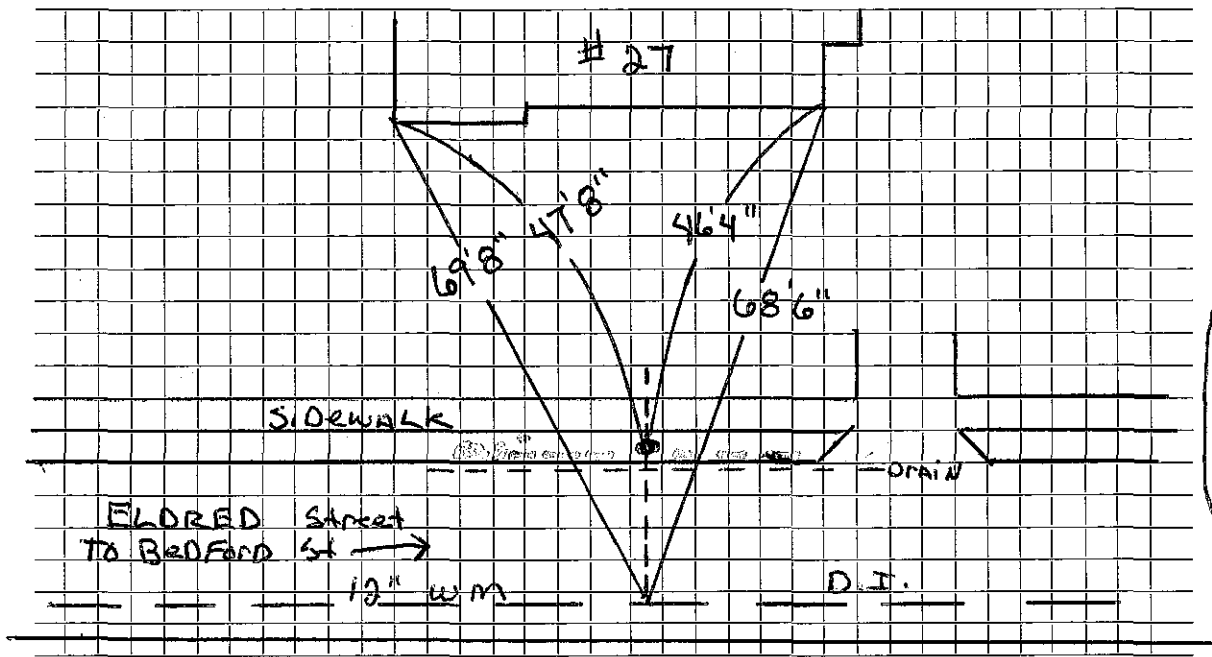

Connection made in ..... Street.

Work completed ~~Installed~~ new main to curb stop..

Remarks: .....

.....

.....