
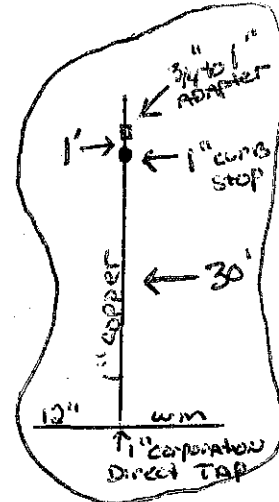


DATE 8-26-20

TOWN OF LEXINGTON — BOARD OF PUBLIC WORKS

WATER DIVISION

Sketch of Service Here

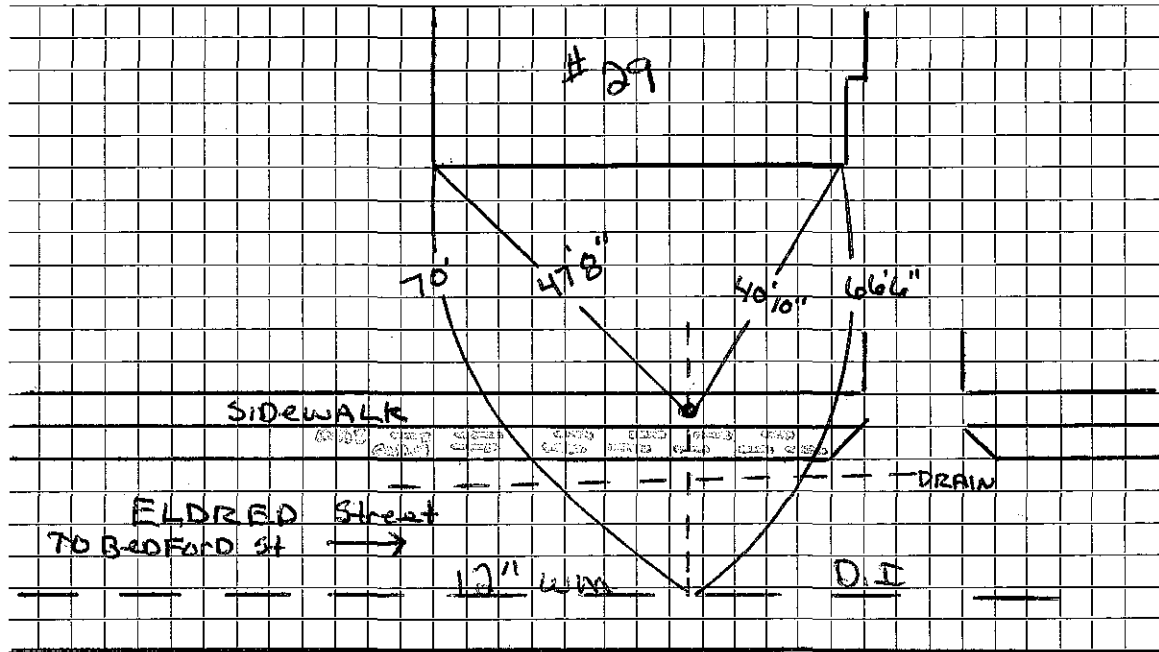

Connection made in Street.

Work completed Installed new main to CURA stop...

Remarks:.....
.....
.....