


Date: 3/4/24

TOWN OF LEXINGTON - BOARD OF PUBLIC WORKS
WATER DIVISION

SKETCH OF SERVICE HERE
3 Eldred St.

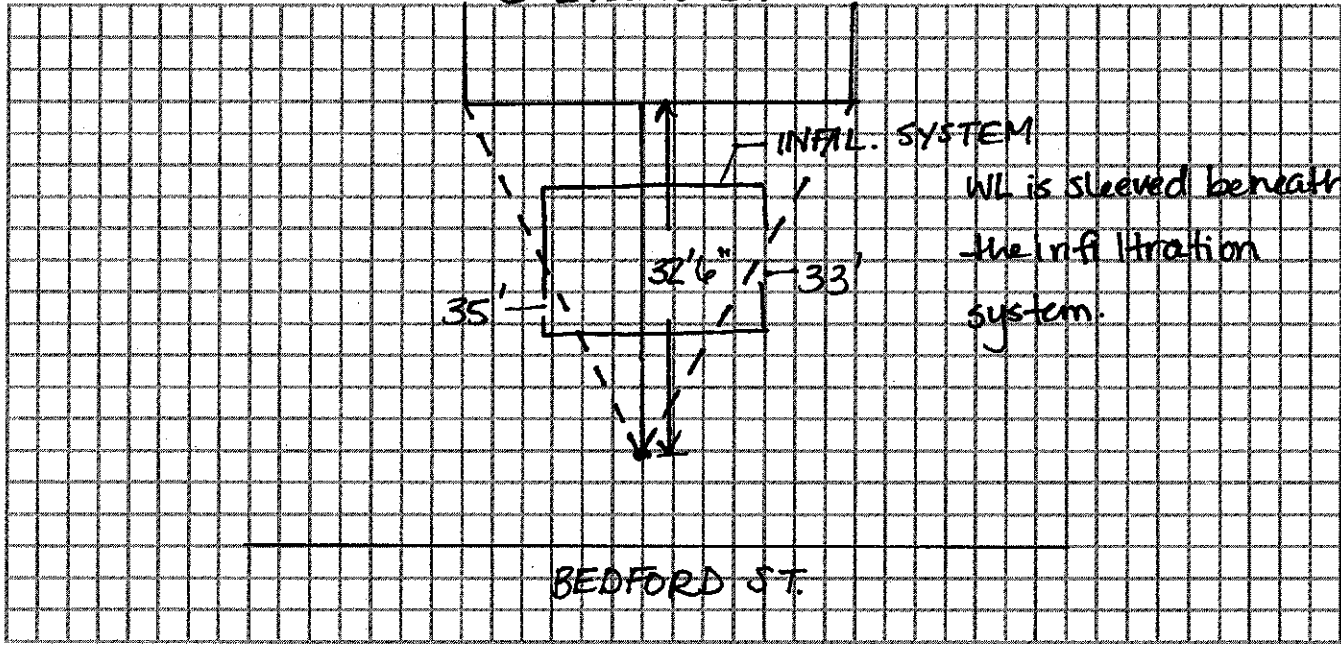

Connection made in: _____ Street. Work completed: _____

Remarks: Installed by UTICON