
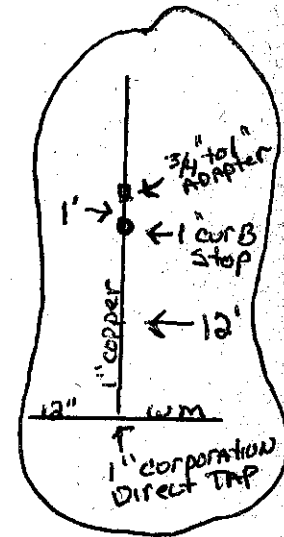


DATE 8-26-20

TOWN OF LEXINGTON — BOARD OF PUBLIC WORKS

WATER DIVISION

Sketch of Service Here

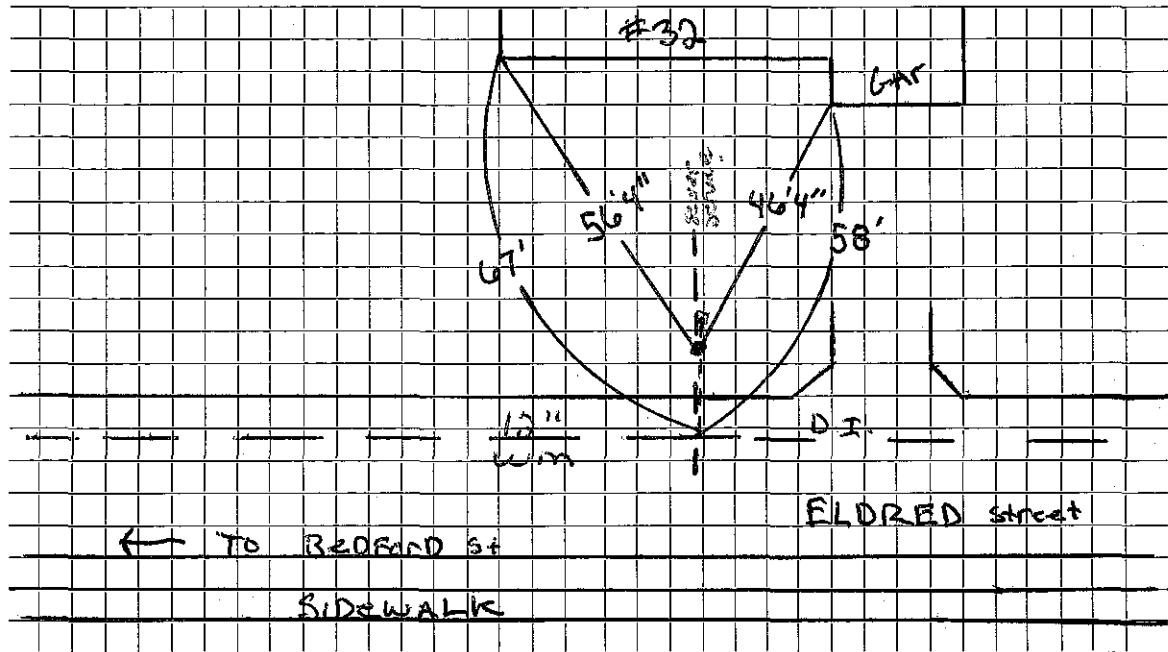

Connection made in.....ELDRED... Street..... Street. Work completed New main to CURB Stop.....

Remarks:.....
.....
.....