
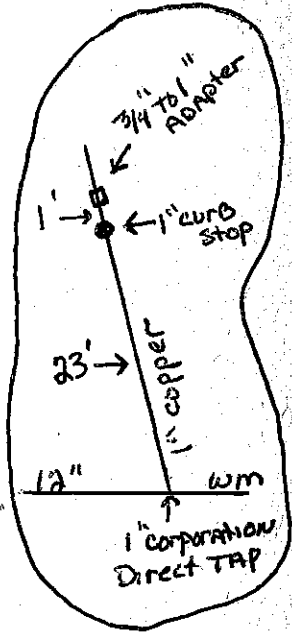


DATE 8-27-20

TOWN OF LEXINGTON — BOARD OF PUBLIC WORKS

WATER DIVISION

Sketch of Service Here

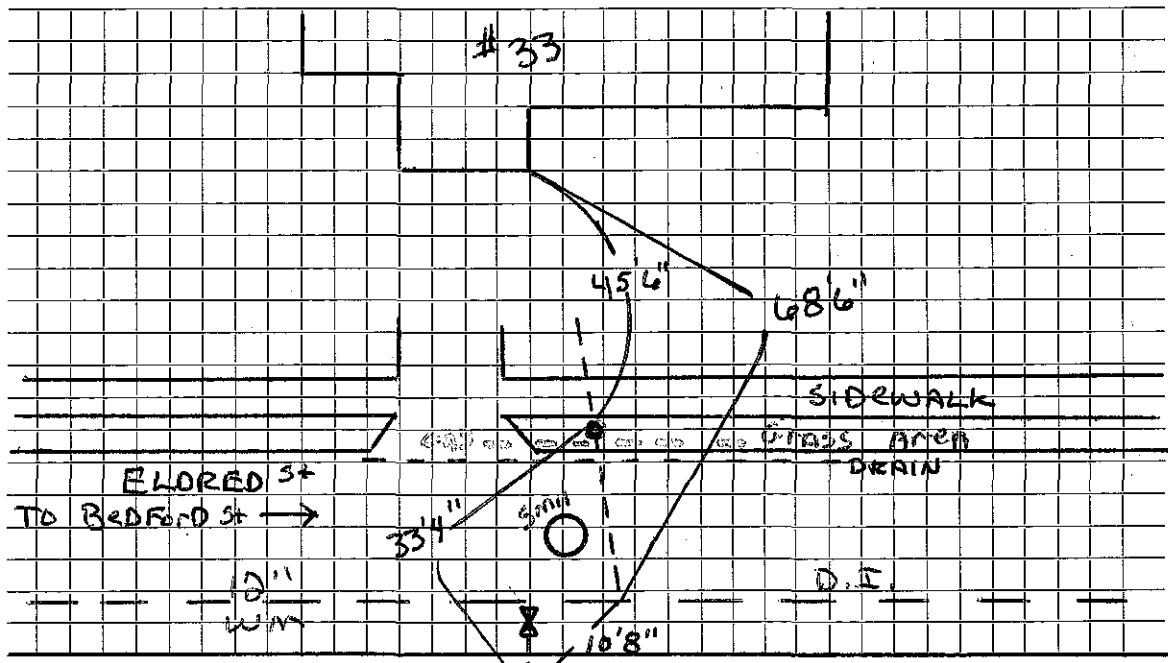

Connection made in Street. Work completed Installed new main to curb stop.....

Remarks:
.....
.....