





DATE 8/26/20

TOWN OF LEXINGTON — BOARD OF PUBLIC WORKS

WATER DIVISION

Sketch of Service Here

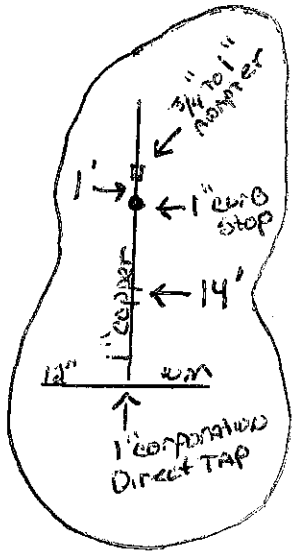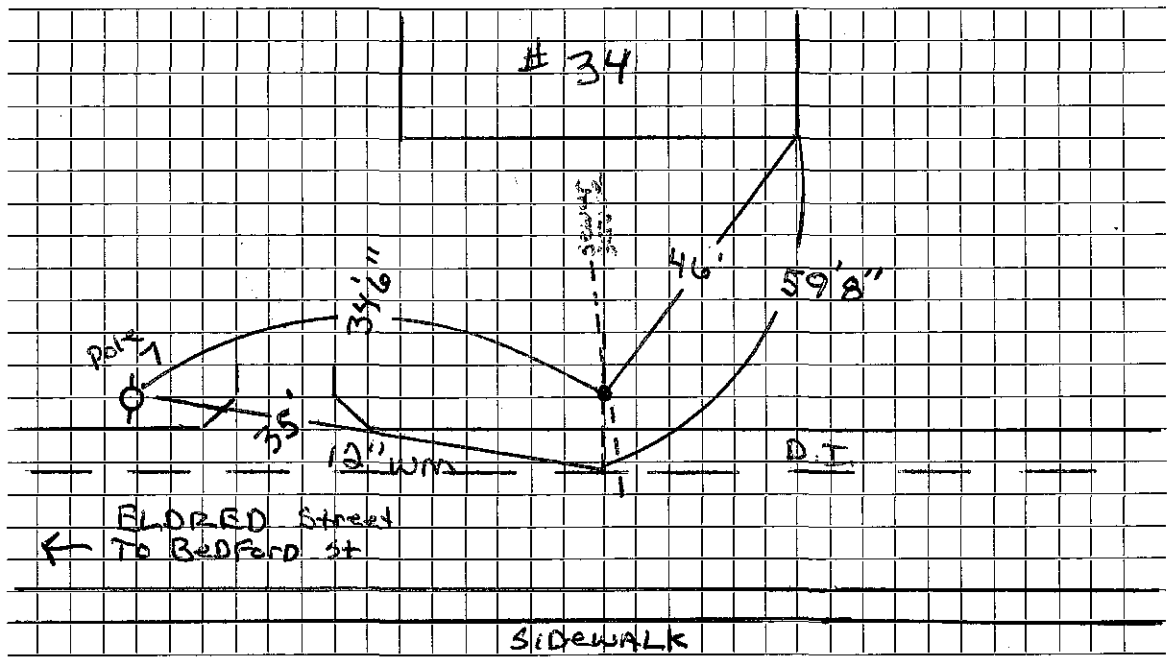

Connection made in ..... Street.

Work completed I installed new main to curb stop.

Remarks: .....

.....

.....