
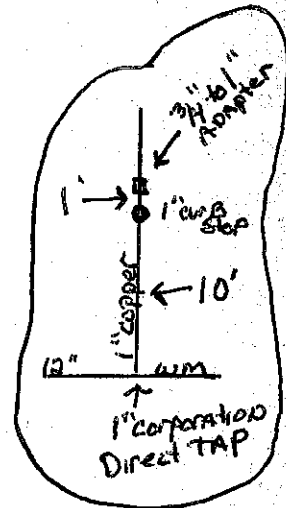


DATE 8-26-20

TOWN OF LEXINGTON — BOARD OF PUBLIC WORKS

WATER DIVISION

Sketch of Service Here

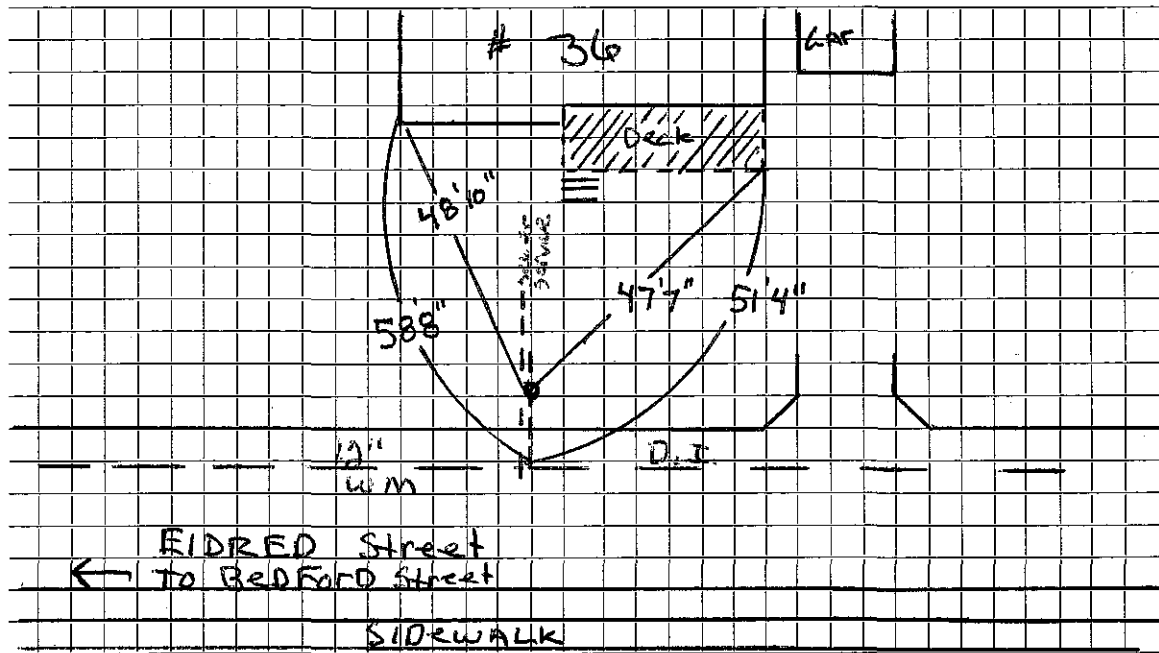

Connection made in Street.

Work completed ~~Installed~~. New. MAIN to. CURB. Stop.

Remarks:

.....

.....