
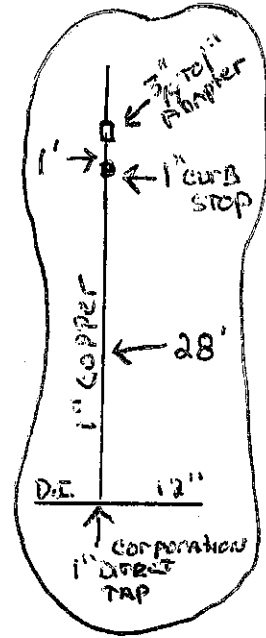


DATE 8-25-20

TOWN OF LEXINGTON — BOARD OF PUBLIC WORKS

WATER DIVISION

Sketch of Service Here

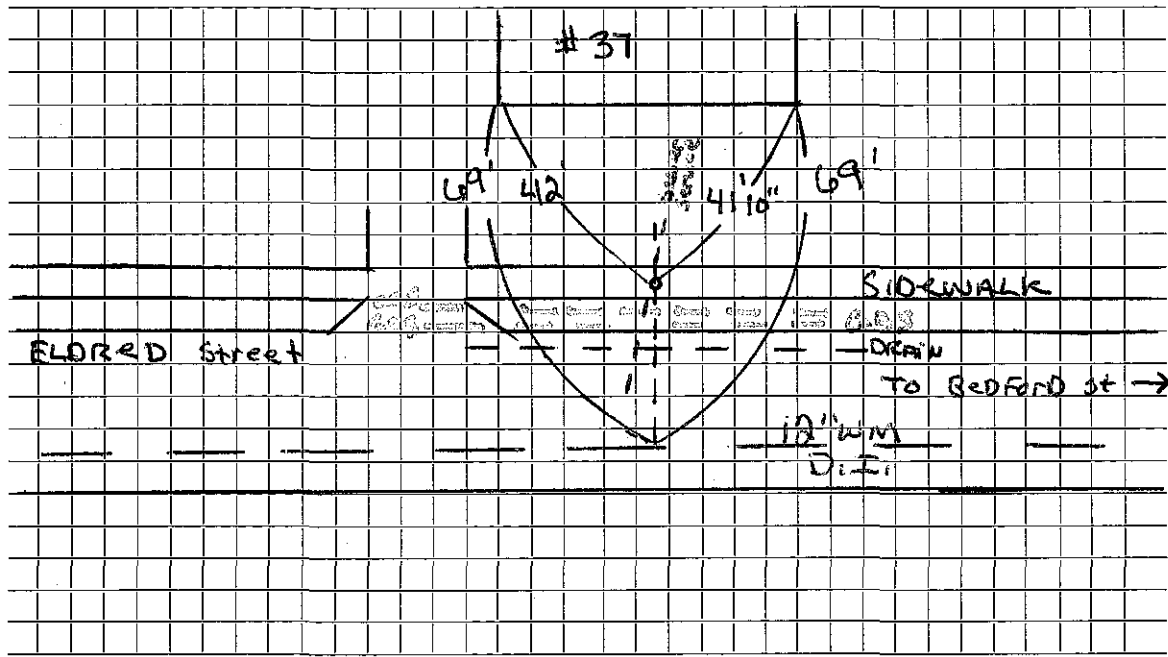

Connection made in... ELDRED... Street..... Street. Work completed New main to curb Stop.....

Remarks:.....
.....
.....