
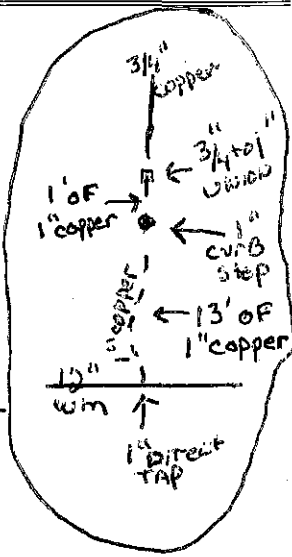


DATE 8/24/20

TOWN OF LEXINGTON — BOARD OF PUBLIC WORKS

WATER DIVISION

Sketch of Service Here

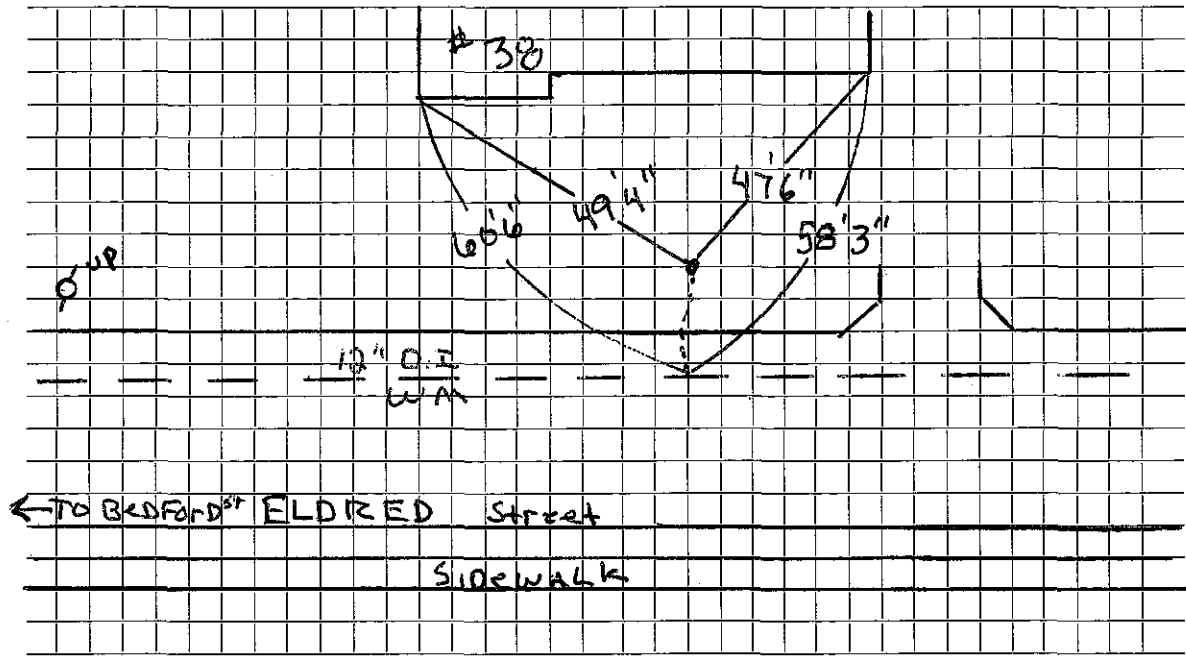

Connection made in.. ELDRED... Street..... Street. Work completed INSTALLED New main to CURB

Remarks:.....
.....
.....