
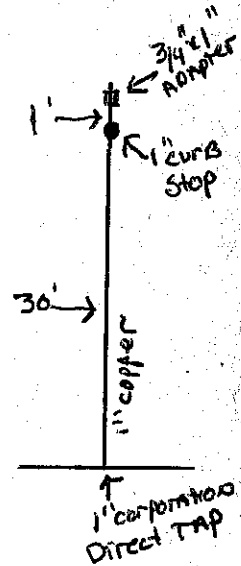


DATE 8-25-20

TOWN OF LEXINGTON — BOARD OF PUBLIC WORKS

WATER DIVISION

Sketch of Service Here

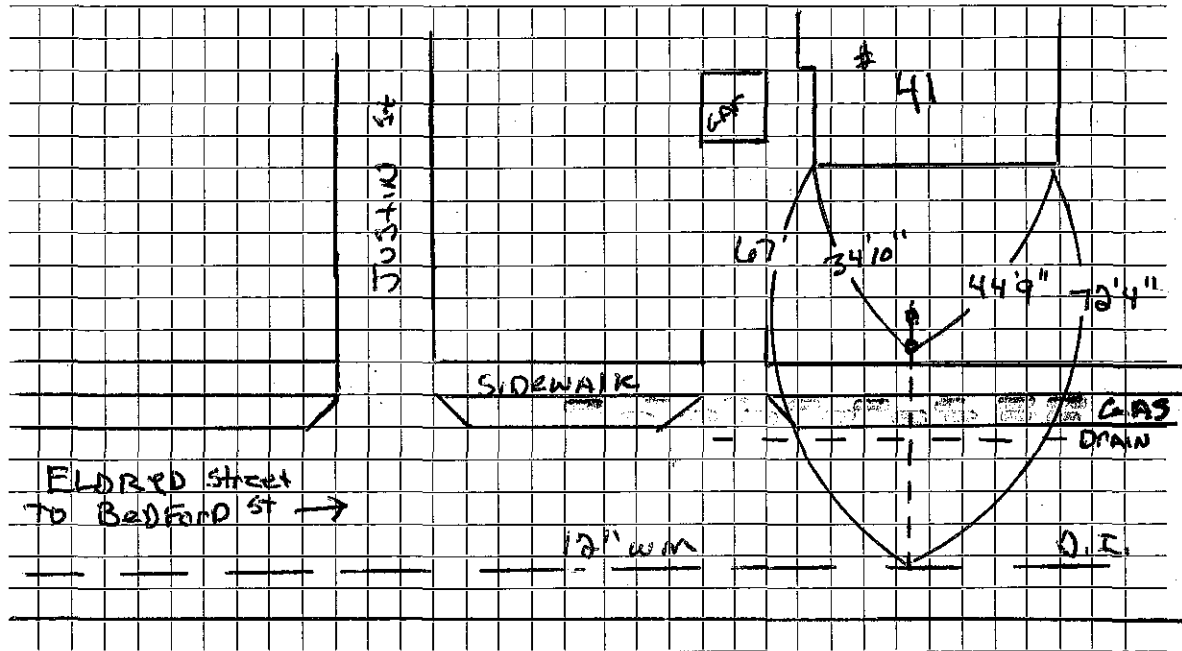

Connection made in... FLORED... Street..... Street.

Work completed New MAIN TO CURB STOP

Remarks:.....
.....
.....