
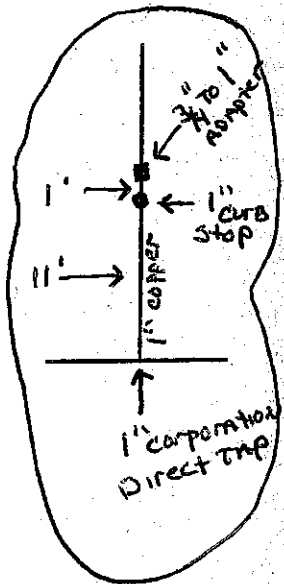


DATE 8-26-20

TOWN OF LEXINGTON — BOARD OF PUBLIC WORKS

WATER DIVISION

Sketch of Service Here

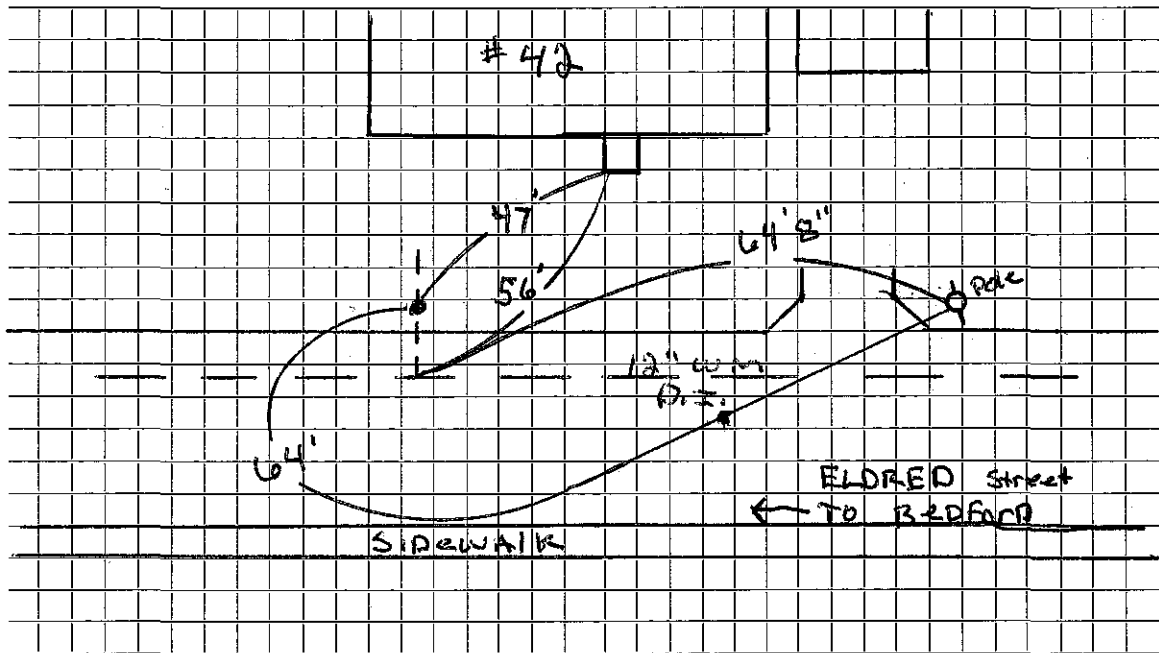

Connection made in... ELDRED... Street..... Street.

Work completed New Main To Curb Stop.....

Remarks:.....
.....
.....