
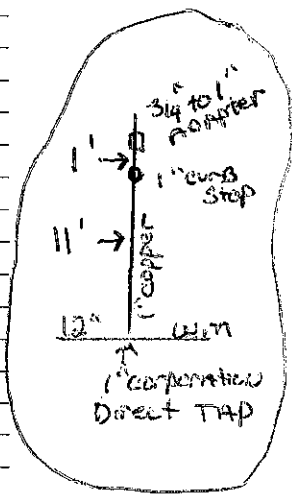


DATE 9-2-20

TOWN OF LEXINGTON — BOARD OF PUBLIC WORKS

WATER DIVISION

Sketch of Service Here

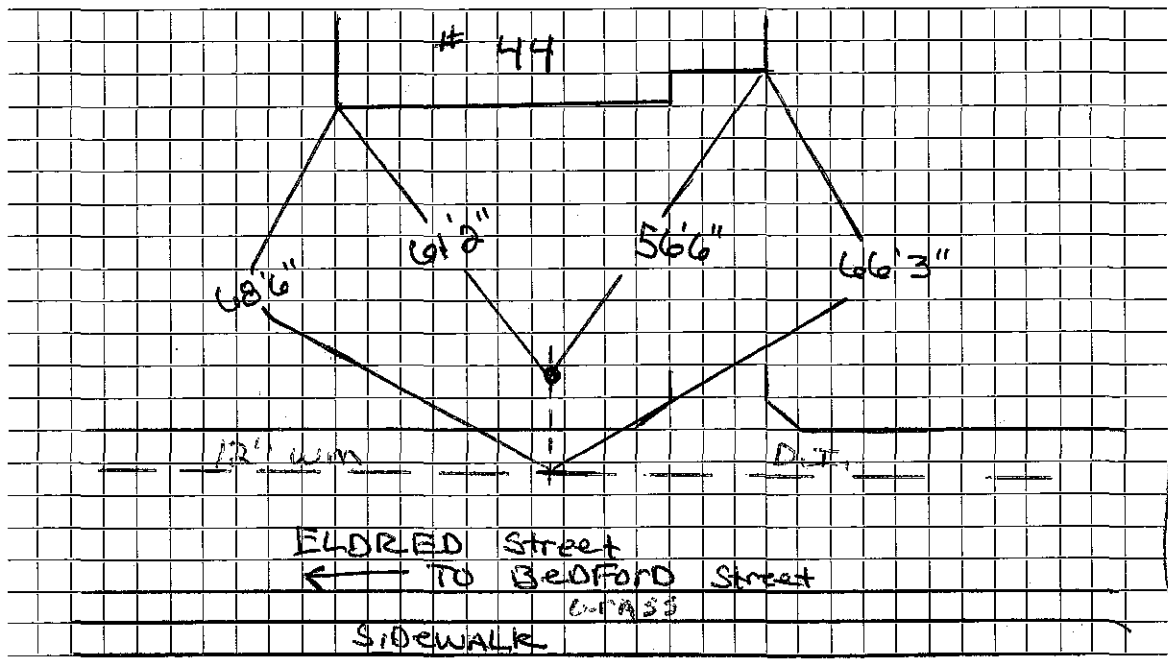

Connection made in Street. Work completed Installed New main to curb stop..

Remarks:
.....
.....