
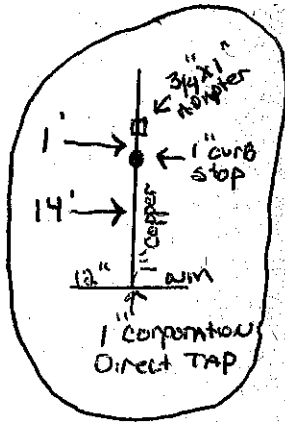


DATE 9-3-20

TOWN OF LEXINGTON — BOARD OF PUBLIC WORKS

WATER DIVISION

Sketch of Service Here

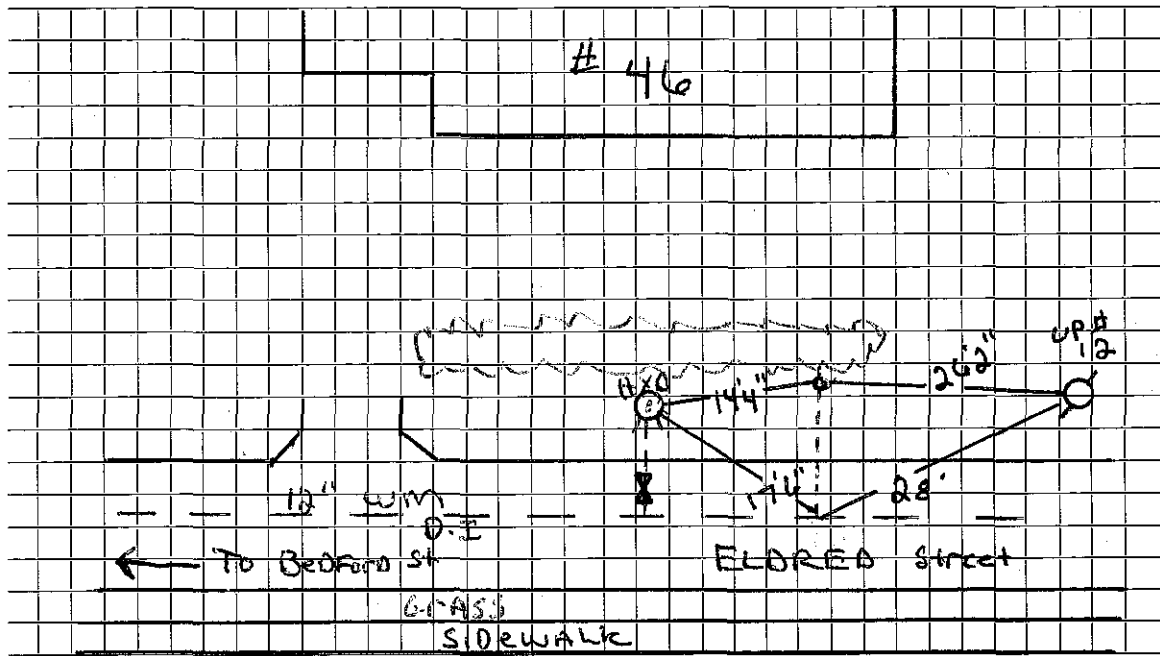

Connection made in Street.

Work completed Installed new main to Curb Stop.

Remarks:.....
.....
.....