
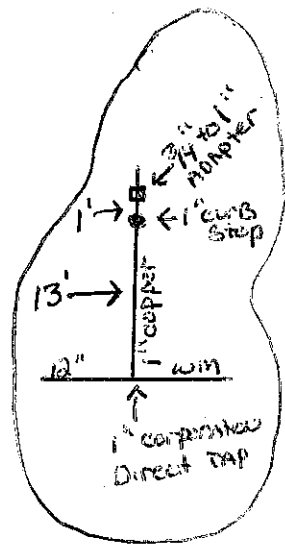


DATE 9-3-20

TOWN OF LEXINGTON — BOARD OF PUBLIC WORKS

WATER DIVISION

Sketch of Service Here

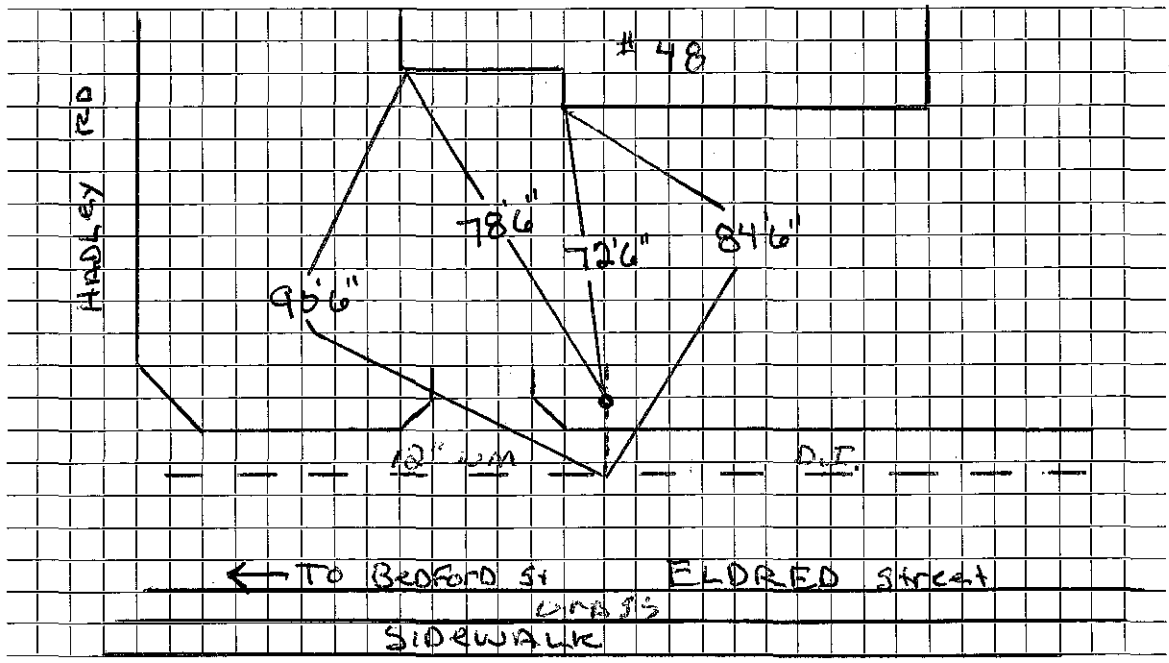

Connection made in..... Street. Work completed Installed new main to curb stop....

Remarks:.....