
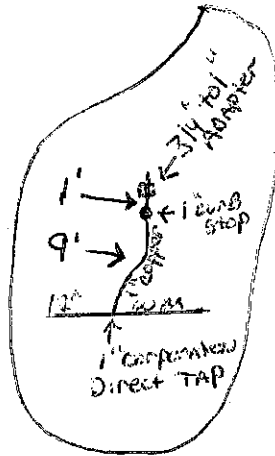


DATE 9-10-20

TOWN OF LEXINGTON — BOARD OF PUBLIC WORKS

WATER DIVISION

Sketch of Service Here

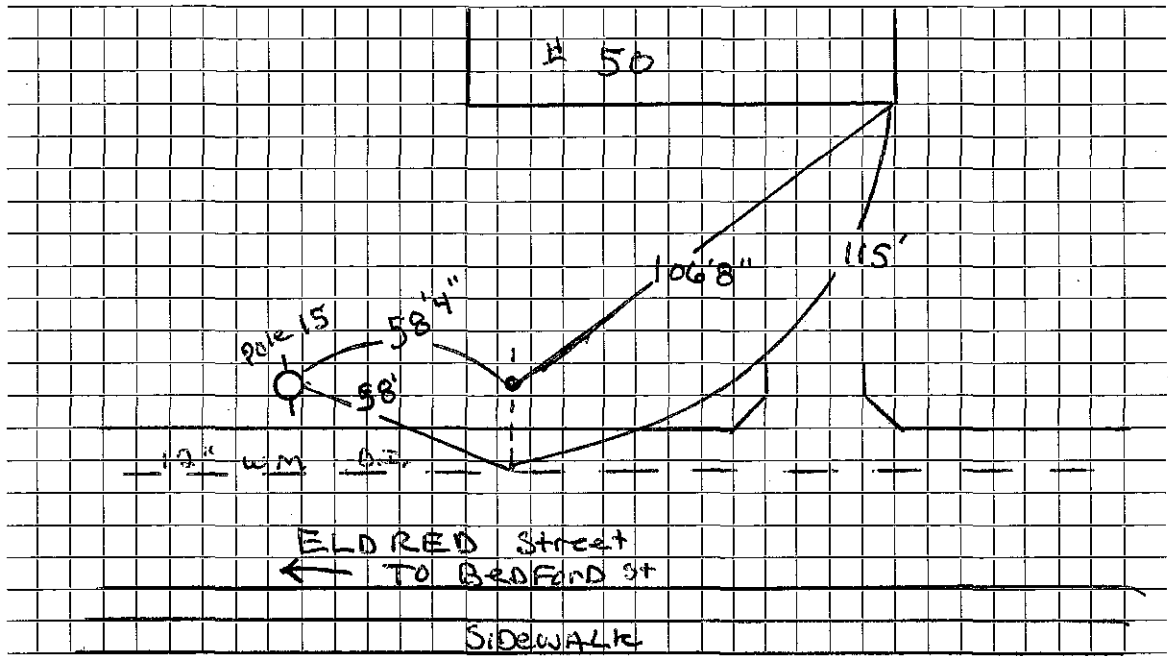

Connection made in Street. Work completed INSTALLED NEW MAIN TO CURB STOP...

Remarks:.....
.....
.....