
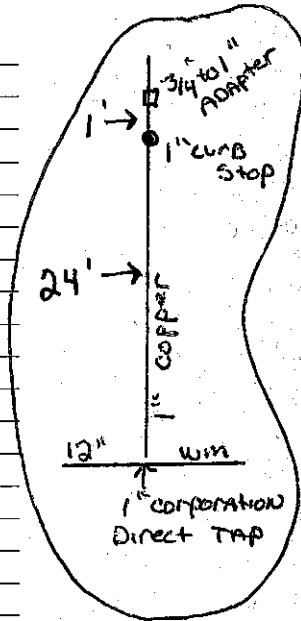


DATE 9-10-20

TOWN OF LEXINGTON — BOARD OF PUBLIC WORKS

WATER DIVISION

Sketch of Service Here

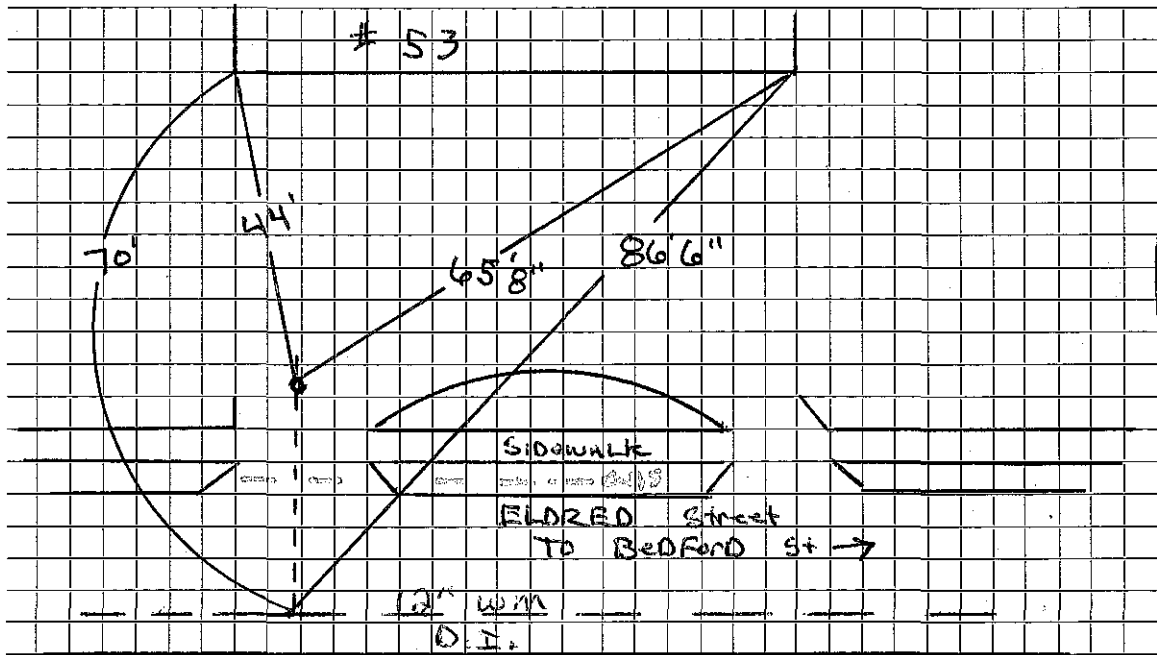

Connection made in Street.

Work completed Installed new main to curb stop...

Remarks:

.....

.....