

**WATER SERVICE RECORD**

Name

Service No.

Address **54 ELDER Street**

Location **FRONT LEFT TAP IN ROAD**

Repair—Renewal—New Service



Date	Material	Amount	Total	Date	Amount
9-10-20	3/4" to 1" ADAPTER	1			
	1" curb stop	1			
	1" copper	15'			
	1" CORPORATION	1			
	CURB BOX BUFFLOW	1			

DATE 9-10-20

TOWN OF LEXINGTON — BOARD OF PUBLIC WORKS

WATER DIVISION

Sketch of Service Here

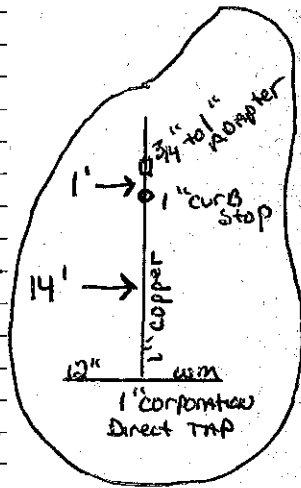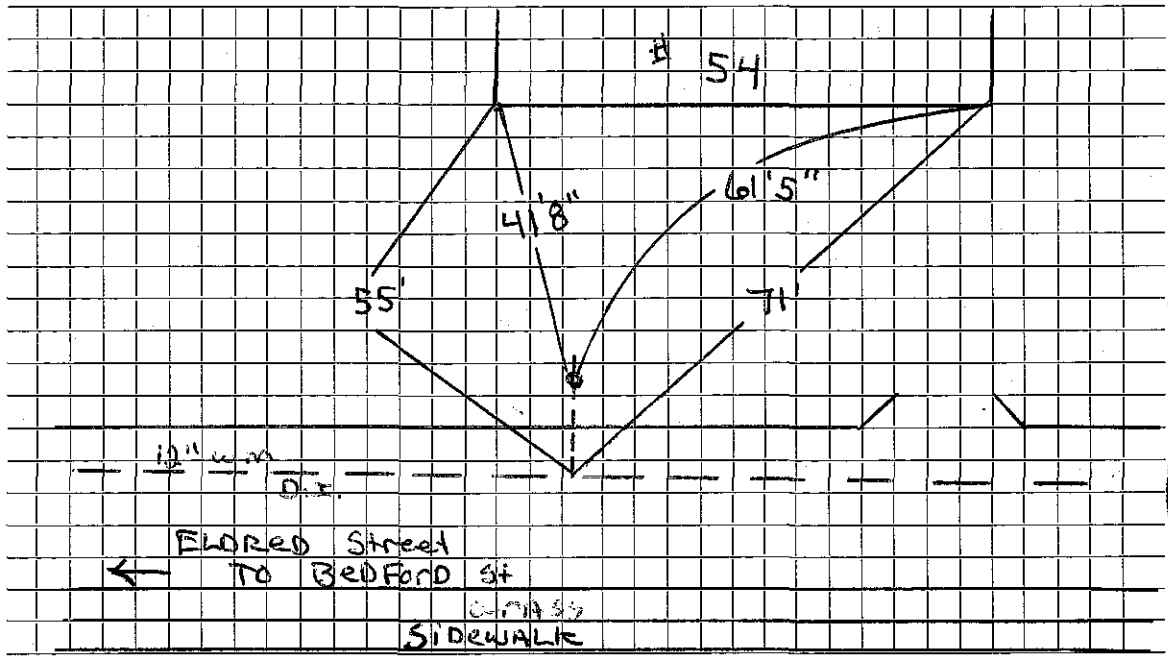

Connection made in ..... Street.

Work completed Installed new main to curb stop.

Remarks: .....

.....

.....