
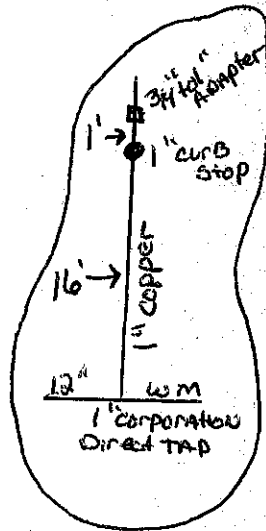


DATE 9-10-20

TOWN OF LEXINGTON — BOARD OF PUBLIC WORKS
WATER DIVISION

Sketch of Service Here

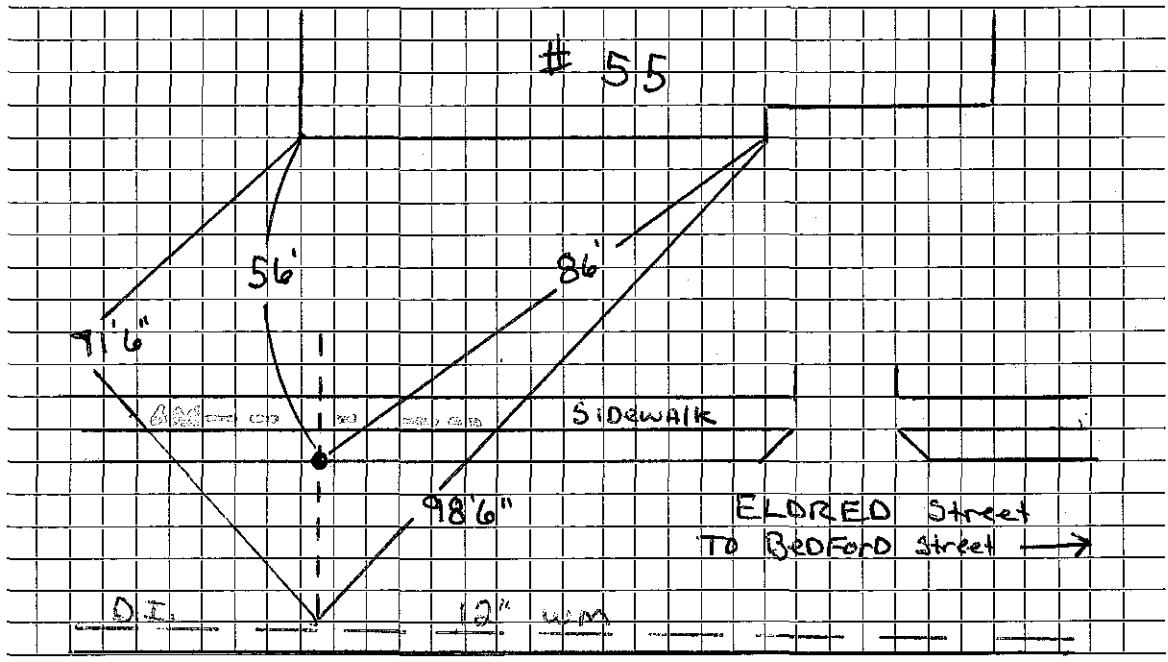

Connection made in Street. Work completed Installed new main to curb stop.

Remarks:
.....
.....