

Name Francis Donovan

Service No. 181

Address 6 Eldred Street

Lexington, Mass.

Location 6 Eldred Street

Kind of Pipe

Size

Size of Main

~~REPAIR~~ ~~RENEW~~ ~~NEW~~ Service

Com. 9-26-49

Location

Date	Material	Amount	Total	Date	Amount
Sept. 16, '49	Labor	2 45	2 45	Sept 16 1949	Deposited
	10% Overhead		25		
	49' - 3/4" Copper Tubing @ .24	11 76			No Charge
	1 - 3/4" C x 1/2" I.W.H. s&w	3 29		Sept. 16, '49	Labor
	Littlefield Shovel 1 1/2 hrs. @ 7.00	10 50			8' - 3/4" Copper Tubing @ .24
	Trucking 1 hr. @ .75		75		1 - 3/4" C Corp-cock
			29 00		1 - 3/4" C x 3/4" C Curb-cock
					1 - Box & Rod
					1 - 1/2" Offset Tail Piece
					1 - 1/2" Straight Tail Piece
					Littlefield Shovel 1 hr. @ 7.00
					Trucking 1 hr. @ .75
	<b>Labor</b>				
					23 61

DATE \_\_\_\_\_

TOWN OF LEXINGTON - BOARD OF PUBLIC WORKS

**WATER DIVISION**

The undersigned applies for a supply of water at No..... St. and hereby agrees to comply with the rules and regulations as now, or at any future time, established by the Board of Selectmen.

Am't of Estimate \$.....

Owner .....


Am't Paid \$.....

Address .....

Builder .....

.....

Sketch of Service Here

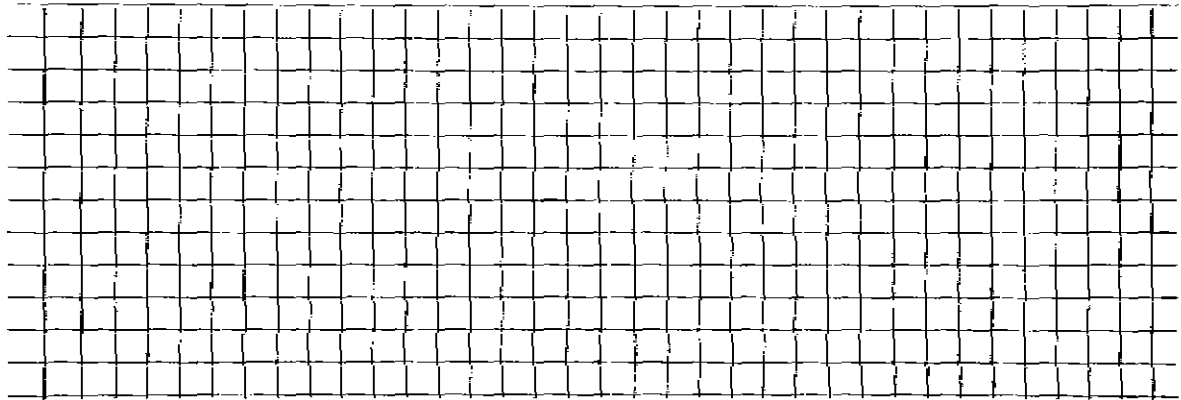

Connection made in ..... Street.

Work completed .....19

Remarks: