




DATE \_\_\_\_\_

TOWN OF LEXINGTON — BOARD OF PUBLIC WORKS  
WATER DIVISION

Sketch of Service Here

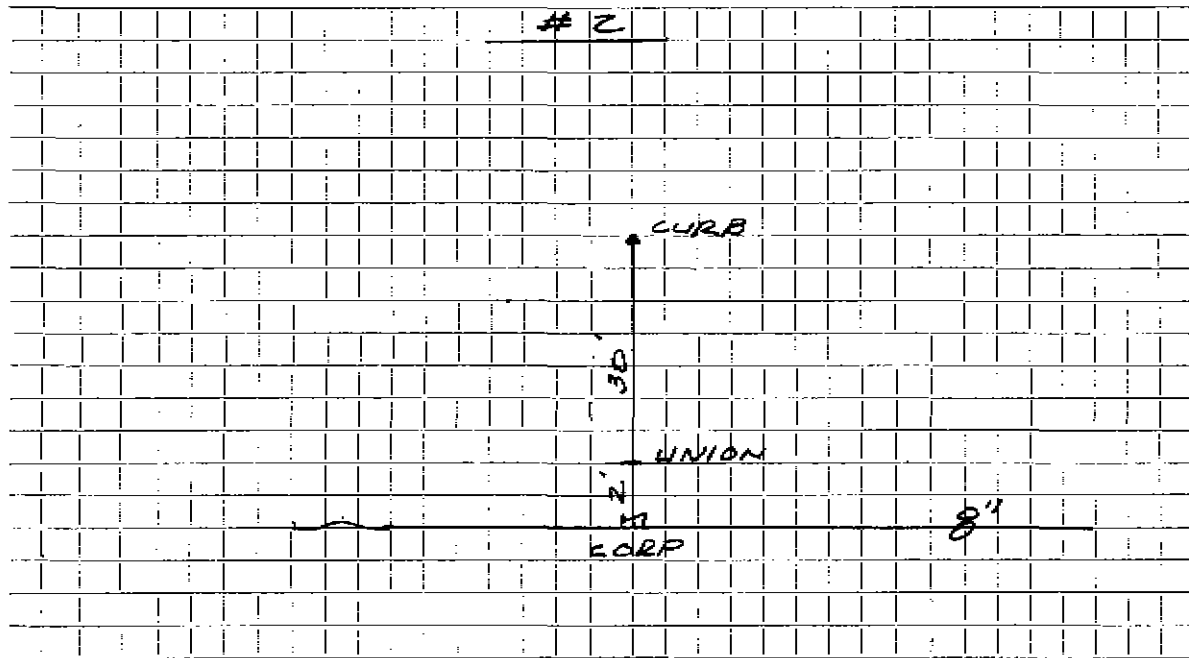

Connection made in MARRETT Street. Work completed .....

Remarks: NEW SERVICE FROM NEW 8" MAIN TO EXISTING COPPER SERVICE