

WATER SERVICE RECORD

Name Uticon, Inc.

Service No.

Address 28 Elliot St

Location

Repair ~~Renewal~~ New Service

| Date | Material | Amount | Total | Date | Amount |
|-----------|---|--------|-------|------|--------|
| 4/30/2020 | 1" type k copper pipe | 58' | | | |
| | 1" direct tap corporation | | | | |
| | 1" curb stop Camb. brass open right | | | | |
| | | | | | |
| | | | | | |
| | | | | | |


DATE 4/30/2020

TOWN OF LEXINGTON — BOARD OF PUBLIC WORKS

WATER DIVISION

Sketch of Service Here

28

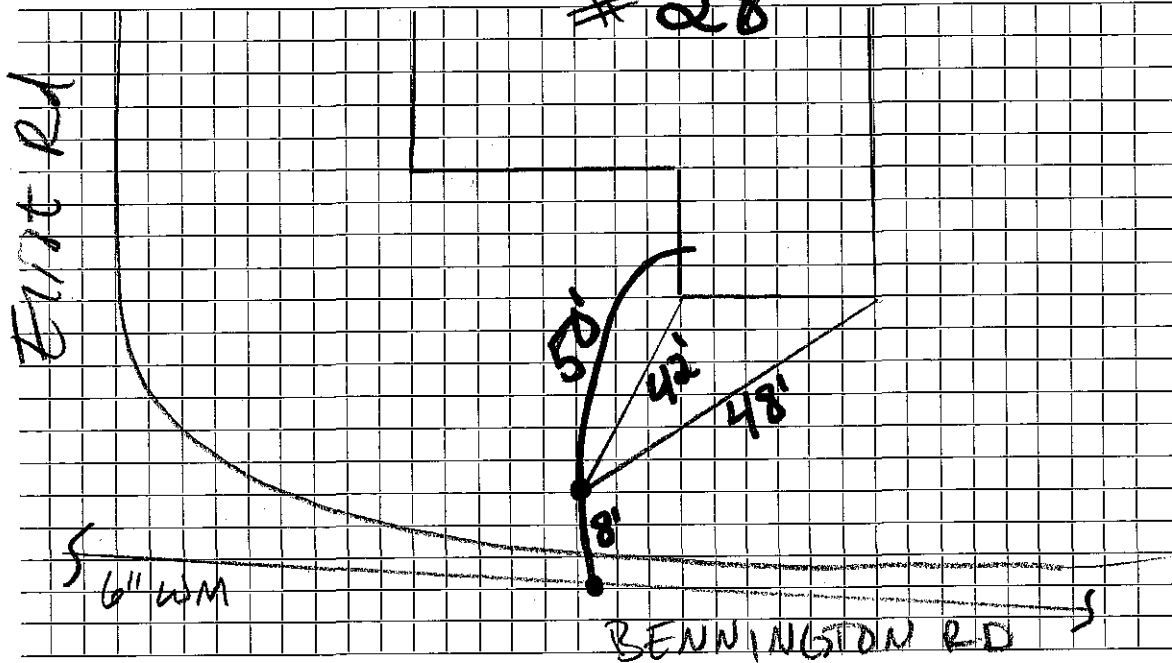

Connection made in Bennington Rd Street: Work completed

Remarks: 4' cover @ main 6' cover @ house