

WATER SERVICE RECORD

1131
Service No.

Name

Address 10 Eliot Road

Location

Repair—~~Renewal~~ New Service W.C. # 7688


Date	Material	Amount	Total	Date	Amount
9-22-28	68' 1 1/4" C.L. Pipe				
	1 1 1/4" S&W				
					Outside
				12/3/68	Labor 23 66
				11/27	" 101 92
				8-	1" Copperpipe .99 7 92
				1-	1" Coupling 60
				1-	1" Corporation 10 66
				1-	1" Curb Cock 14 43
					Box & Rod 5 10
				6	Ton Gravel 1.40 8 40
				2 1/2	Ton cold patch 5.50 2 75
				3 1/2	Hrs. Trucking 3.00 10 50
				1	" " 1 50
				1	" Shovel 6.50 12 50
					Holler 3 88
					Trailer 2 00
					211 94

DATE _____

TOWN OF LEXINGTON — BOARD OF PUBLIC WORKS

WATER DIVISION

Sketch of Service Here

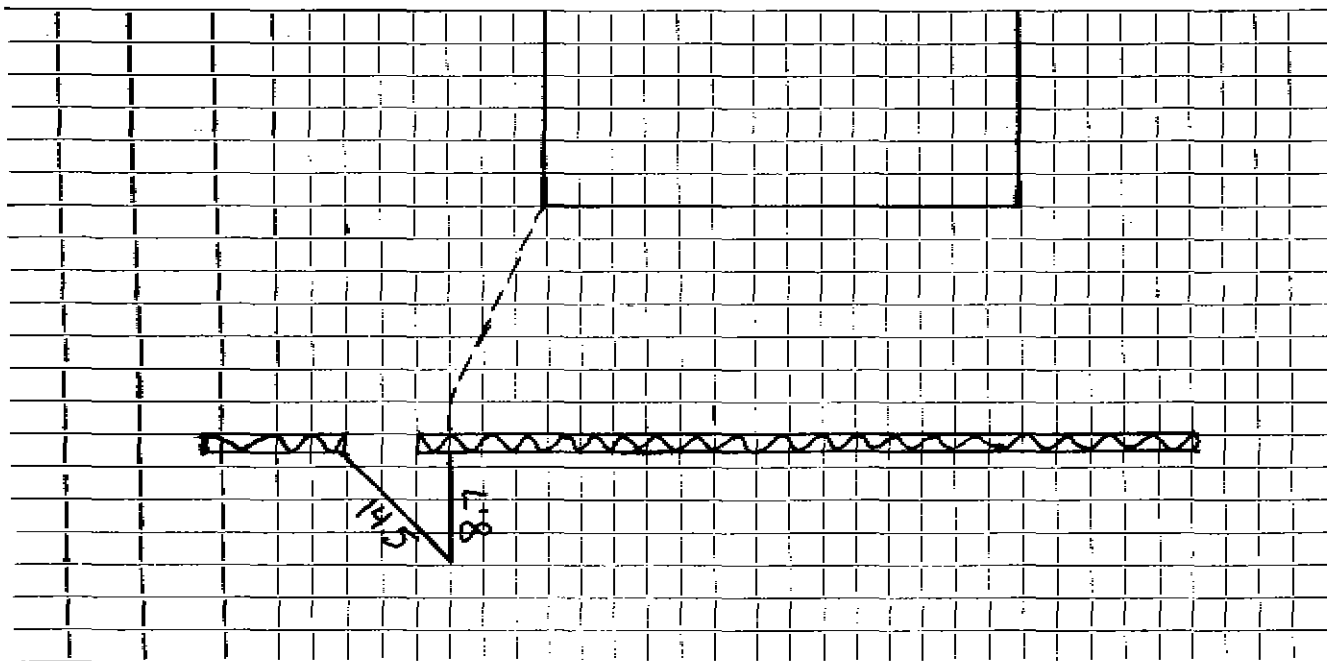

Connection made in _____ Street. Work completed _____

Remarks: _____

