

WATER SERVICE RECORD

Name Ivan K. Hoyt

Service No. _____

Address 11 Eliot Road

Location _____


~~Repair—Renewal—New Service~~
 XXXXXX XXXXXXXXXXXX Arlex #4126

Date		Material	Amount	Total	Date		Amount
5/24/85	37'	3/4" Copper Tubing					
	1	3/4" R.H. Wheel Valve					
						OUTSIDE	
					10/8/74	24' 3/4" Copper tubing	
						1 3/4" Curb Cock	
						1 3/4" Corp Cock	
						1 Box & Rod	

DATE 10-8-74

TOWN OF LEXINGTON — BOARD OF PUBLIC WORKS
WATER DIVISION

Sketch of Service Here

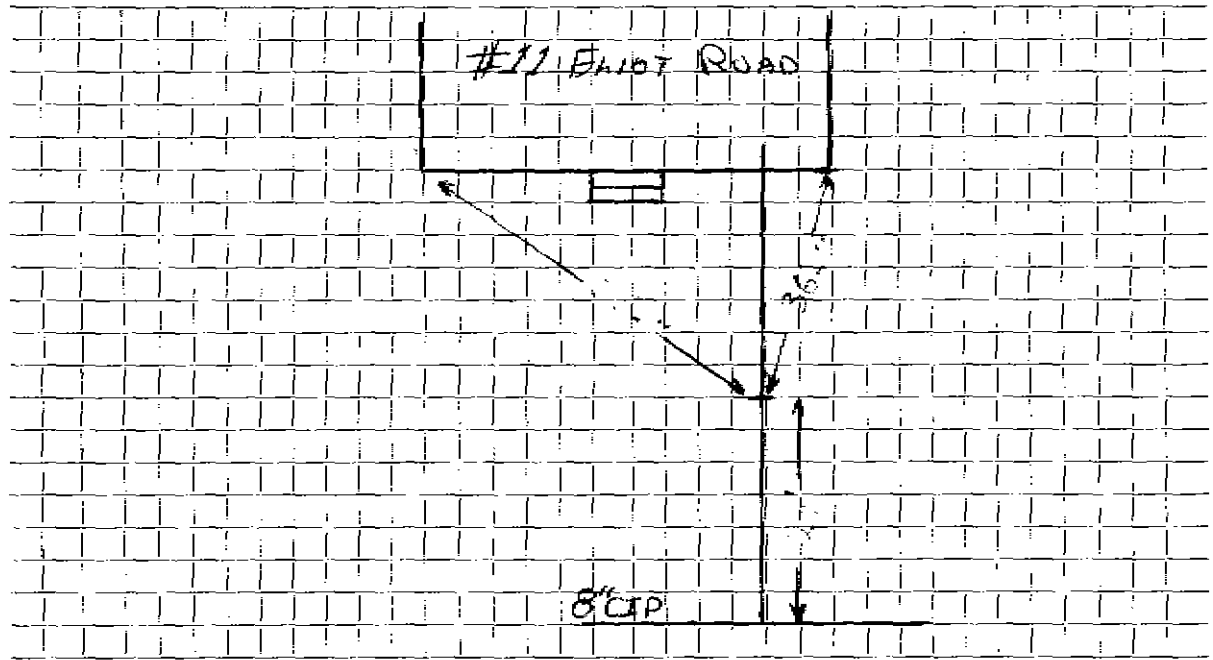

Connection made in ELIOT ROAD Street. Work completed 5-24-85

Remarks: WATER + SEWER IN SAME TRENCH