

WATER SERVICE RECORD

Name Lester L. Andrews

Service No. 24

Address 14 Eliot Rd.

Location

Repair—Renewal—~~NEW SERVICE~~  
XXXXXX

W.O. # 8818

SEP 21 1970


Date	Material	Amount	Total	Date	Amount
8/6/70	Labor	84 06		7-24-70	500 00
8/7/70	"	70 05	154 11	9-21-70	114 74
	10% O.H.		15 41		385 26
110'	1" Copper pipe .99		108 90		
1	1" Union		2 81		
					<u>OUTSIDE</u>
1	1" Wheel Valve		12 53	8/6/70	Labor 28 02
10	Yds, Loam 3.50		35 00	8/7/70	" 42 03
5	Lbs, Grass Seed 1.10		5 50	8/28/70	" 16 39
4	Hrs, Trucking 3.00		12 00	10'	1" Copper pipe .99 9 90
6	" Shovel 6.50		39 00	1	1" Curb cock 14 43
			385 26	1	1" Corp. 10 66
				1/4	Ton cold patch 6.00 1 50
					Box & Rod 5 10
				3 1/2	Hrs, Trucking 3.00 10 50
				2	" Shovel 4.00 8 00
				1	" Compressor 4 00
					<u>150 53</u>

DATE \_\_\_\_\_

TOWN OF LEXINGTON — BOARD OF PUBLIC WORKS

WATER DIVISION

Sketch of Service Here

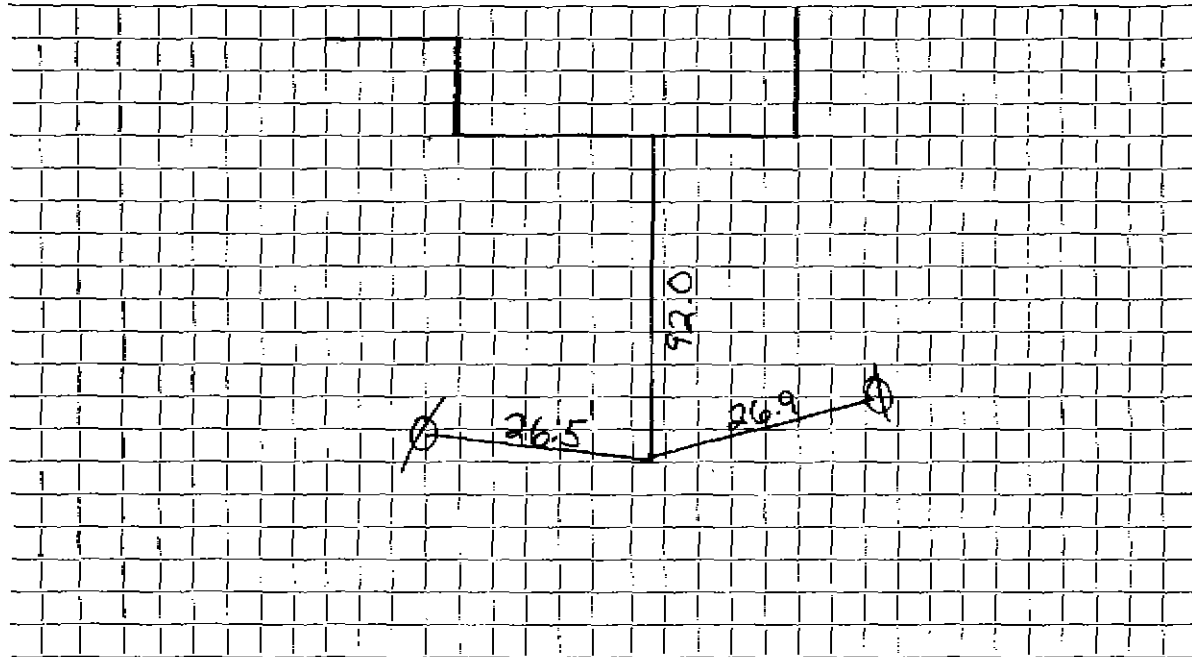

Connection made in ..... Street. Work completed .....

Remarks: .....  
.....  
.....