

WATER SERVICE RECORD

#1001

Name Edward W. Sibley

Service No. 46

Address 18 Eliot Road

Location


~~REPAIRS~~ New Service

Comm 8-4-58

Date	Material	Amount	Total	Date	Amount
4-30-58	Labor	1.91		4-14-58	35.88
	10% overhead	.19	2.10	8-4-58	4.99
60'	3/4" Copper tubing @.37		22.20		38.87
1	3/4" Cx 1/2 I.W.H. Stop & Waste		4.96		
1	hrs. Trucking @.75		.75		
			30.01	4-30-58	
					NON CHARGE
					Labor
				10'	3/4" Copper Tubing @.37
				1	3/4" C Gurb Cock
				1	3/4" C Adapter
				1	Box & Rod
				1	1/2 Offset tail piece
				1	1/2 Straight tail piece
					19.20

WATER DIVISION

Sketch of Service Here

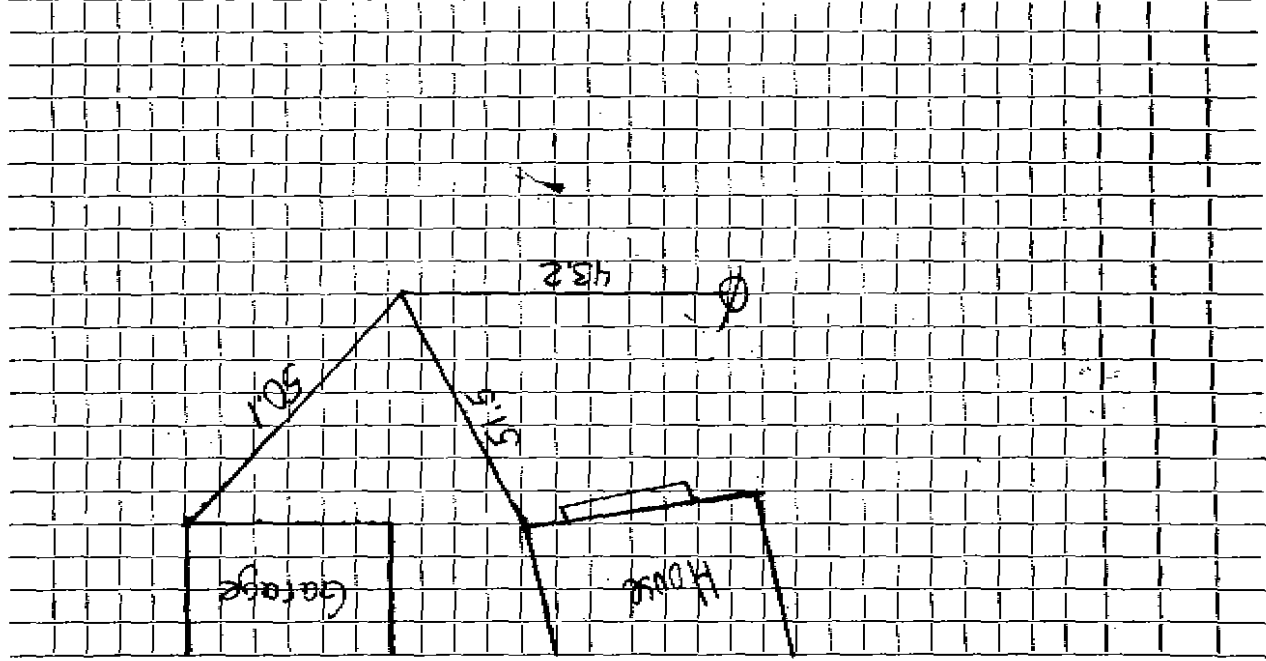

Connection made in

Street.

Work completed

Remarks: