

Answer to diggers trench

DATE Aug. 14/29

TOWN OF LEXINGTON—BOARD OF PUBLIC WORKS WATER DIVISION

The undersigned applies for a supply of water at No. Eliot Rd. cor Warren St. and hereby agrees to comply with the rules and regulations as now, or at any future time, established by the Board of Selectmen.

Am't. of Estimate \$ 65 for 100'


Owner Irmas L. Dowling

Am't. Paid \$ _____ 10/29/29

Address Highland Ave.
Lex.

Builder D. G. Generoso & Co.
657 Main St., Waltham

Sketch of Service Here

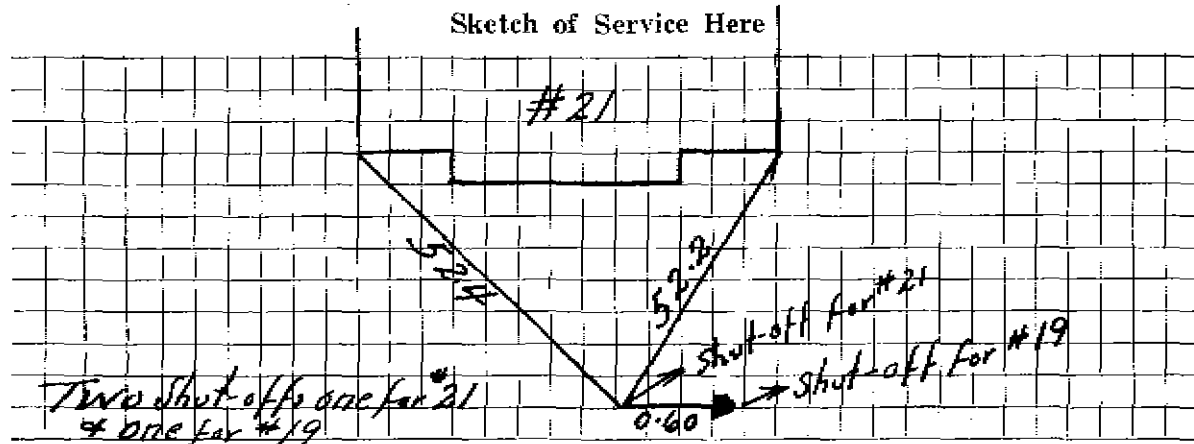

Connection made in _____ Street. Work completed _____ 19

Remarks: