

~~11~~ 3100

WATER SERVICE RECORD

Name Timothy Quinlan

Service No. 128

Address 2 Eliot Road

Location

~~REPAIR~~ ~~RENEWAL~~ - New Service

CON. 7-18-54


Date	Material	Amount	Total	Date	Amount
6/24/54	Labor	1 85		6-4-54 Deposited	25 00
	10% overhead	19	2 04	7-20-54 Refunded	1 76
	47' - 3/4" copper tubing@.35	16 45			<u>23 24</u>
	1 -3/4"C x 1/2 I.W.H. stop & waste	4 00	6/24/54 Labor		1 85
	1 hr. trucking		75	5' - 3/4" copper tubing@.35	1 75
			<u>23 24</u>	1 -3/4"C. corp-cock	4 33
				1 - 3/4"C. curb-cock	4 67
				1 box and rod	3 90
				1 - 1/2 straight tail pc.	50
				1 - 1/2 offset tail pc.	50
				1 hr. trucking	<u>75</u>
					18 25

DATE _____

TOWN OF LEXINGTON — BOARD OF PUBLIC WORKS

WATER DIVISION

Sketch of Service Here

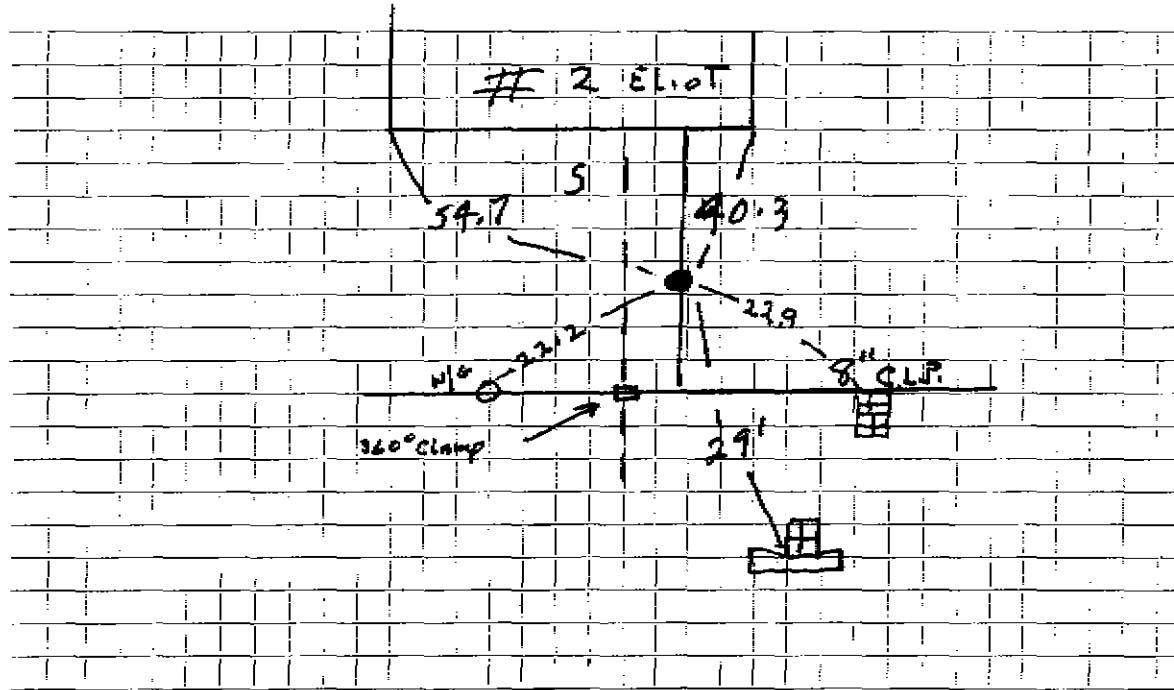

Connection made in Street: Work completed

Remarks: *sewer 1/2" under water main at clamp*

.....
.....