

WATER SERVICE RECORD

Name Mr. Minot

Service No.

3149
169 N.D.

Address 22 Elliot Road

Location

~~Repair~~—Renewal—~~New Service~~

Comm 8-22-60


Date	Material	Amount	Total	Date	Amount
8-3-60	Labor	3 88		9-12-60	32 74
	10% O.H.	39	4 27		
	46' 1" Copper tubing @ 4676		21 51		
	1 1" Ox 1" Comp. valve		6 96		
			32 74		
					NON CHARGE
				10'	Labor 3 22
					1" Copper tubing @ 4676 4 68
				1	1" Adapter 3 29
				1	1" Curb Cock 6 06
				1	Box & Rod 4 90
				1	1" offset tailpiece 93
				1	1" Straigh tailpiece 93
					26 01

DATE _____

TOWN OF LEXINGTON — BOARD OF PUBLIC WORKS

WATER DIVISION

Sketch of Service Here

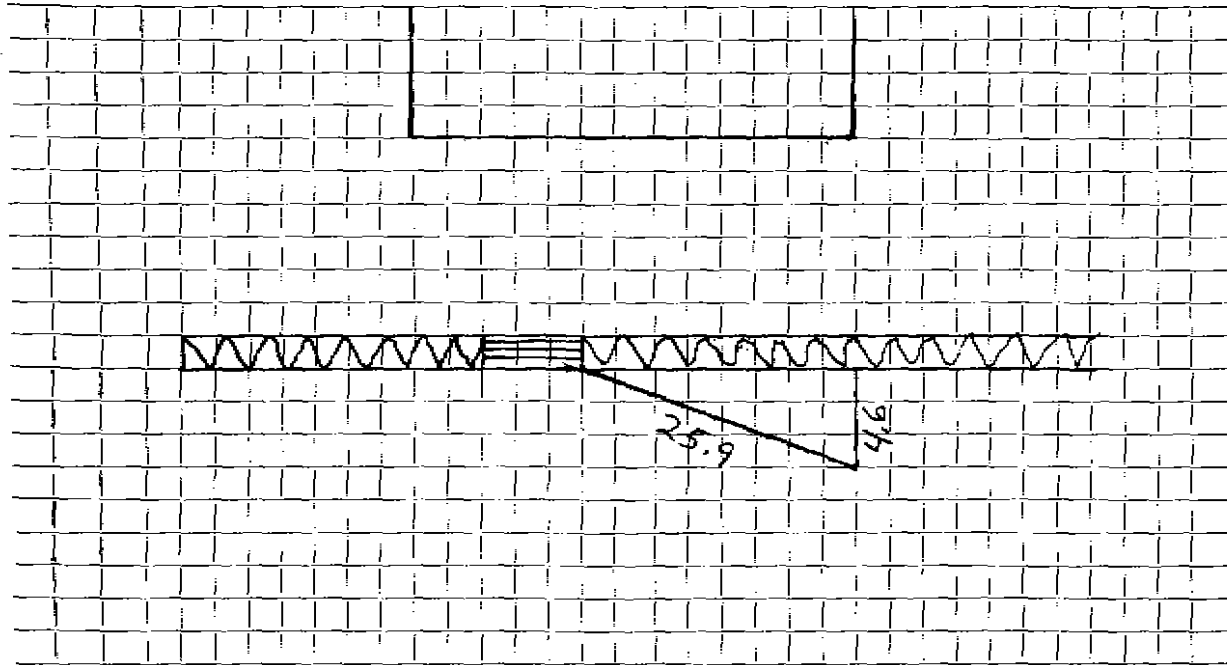

Connection made in Street. Work completed

Remarks:

.....
.....