

Name Carroll Williams

Service No. 809 28 (167)

Address 27 Eliot Road

5223

Location *27 Eliot Rd.*

Kind of Pipe

Size

Size of Main

Repair—Renewal—New Service

Location **MAR 18 1968**

Date	Material	Amount	Total
	RENEWAL W.C. (4783)		
6/8/67	Labor 54.64	54 64	
	10% O.H.	<u>5 46</u>	60 10
50'	1" coppertubing @.99		49 50
1	stop & waste		9 70
5½	hrs. shovel @6.50		35 75
2	hrs. trucking @6.00		<u>6 00</u>
	Labor		161 05

Date	Material	Amount
	OUTSIDE	
6/12/67	Labor	16.60
6/13/67	Labor	<u>13.90</u>
26'	1" copper Tub. @.99	25 74
1	Corporation	10 66
1	Curb cock	11 15
1	Box and rod	5 10
1	Ton cold patch	5 00
2	Ton hot top @5.80	11 60
3	Yards loam @ 3.25	9 75
1	Lb. grass seed	1 10
1	Hr. shovel	6 50
2	Hrs. trucking	6 00
½	Hr. compressor	<u>2 50</u>
		125 60
3-17-67	Deposit	200 00
3-18-67	Refund	38 25
		<u>161 75</u>

Hudley Press, Inc., Lexington

TOWN OF LEXINGTON—BOARD OF PUBLIC WORKS

WATER DIVISION

The undersigned applies for a supply of water at No. _____ St. and hereby agrees to comply with the rules and regulations as now, or at any future time, established by the Board of Selectmen.

Am't. of Estimate \$ _____

Owner

Dr. C. P. Briggs


Am't. Paid \$ _____

Address

27 Eliot Rd.

Builder _____

Sketch of Service Here

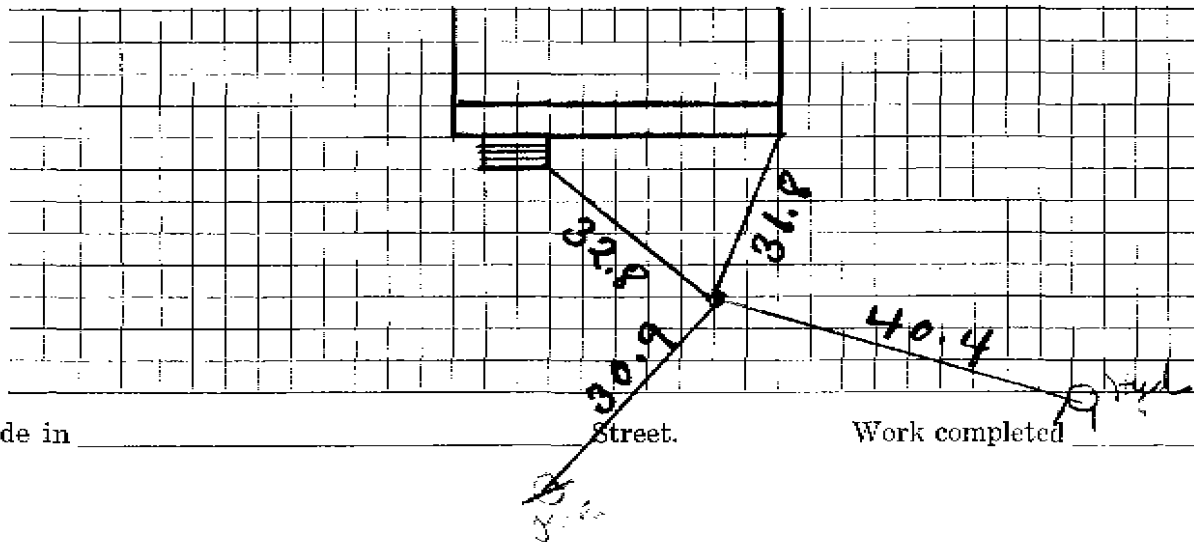

Connection made in _____

Street.

Work completed _____

Remarks: