

Water Service Record

Name

Service No.

Address

32 Eliot Rd

Location

Repair - Renewal


New Service

Date	Material	Amount	Total	Date		Amount
5/5/20	1" type K copper					
	1" curb stop open right camba brass					
	Buffalo Box					
	1" corporation					

TOWN OF LEXINGTON - BOARD OF PUBLIC WORKS
WATER DIVISION

Date: 5/5/2020

SKETCH OF SERVICE HERE

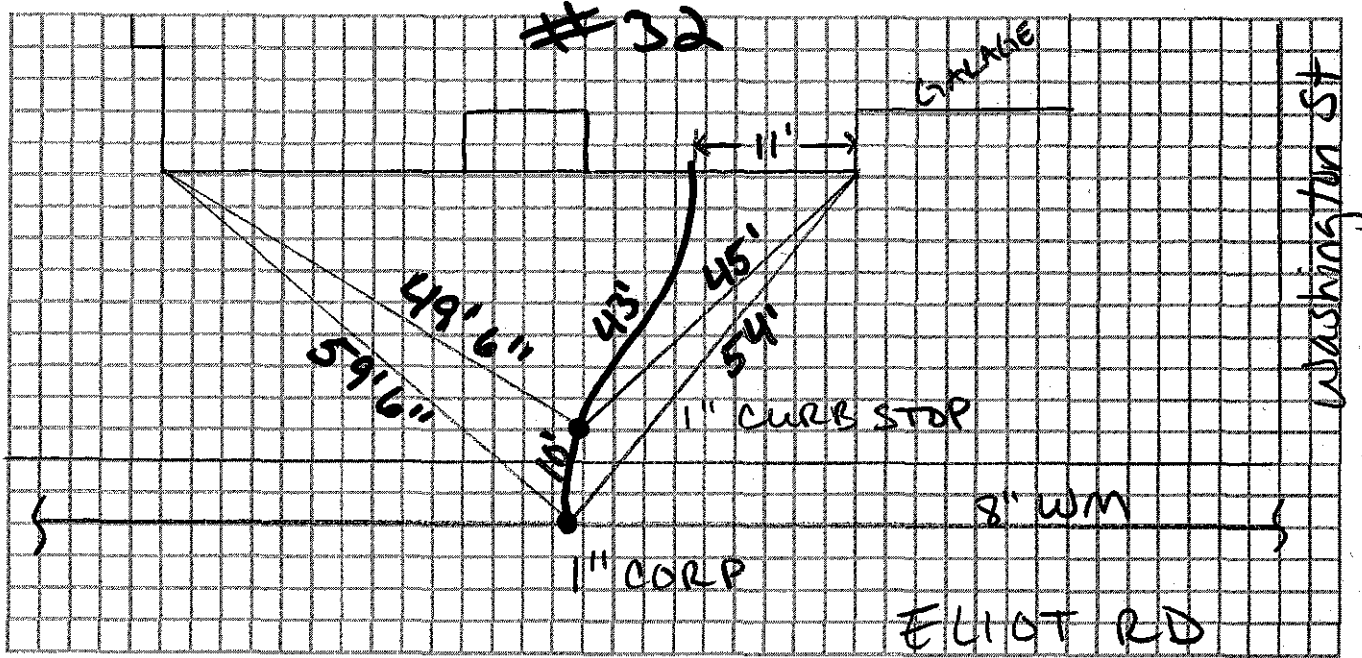

Connection made in: Eliot Rd Street. Work completed:

Remarks: