




DATE \_\_\_\_\_

**TOWN OF LEXINGTON — BOARD OF PUBLIC WORKS**

**WATER DIVISION**

Sketch of Service Here

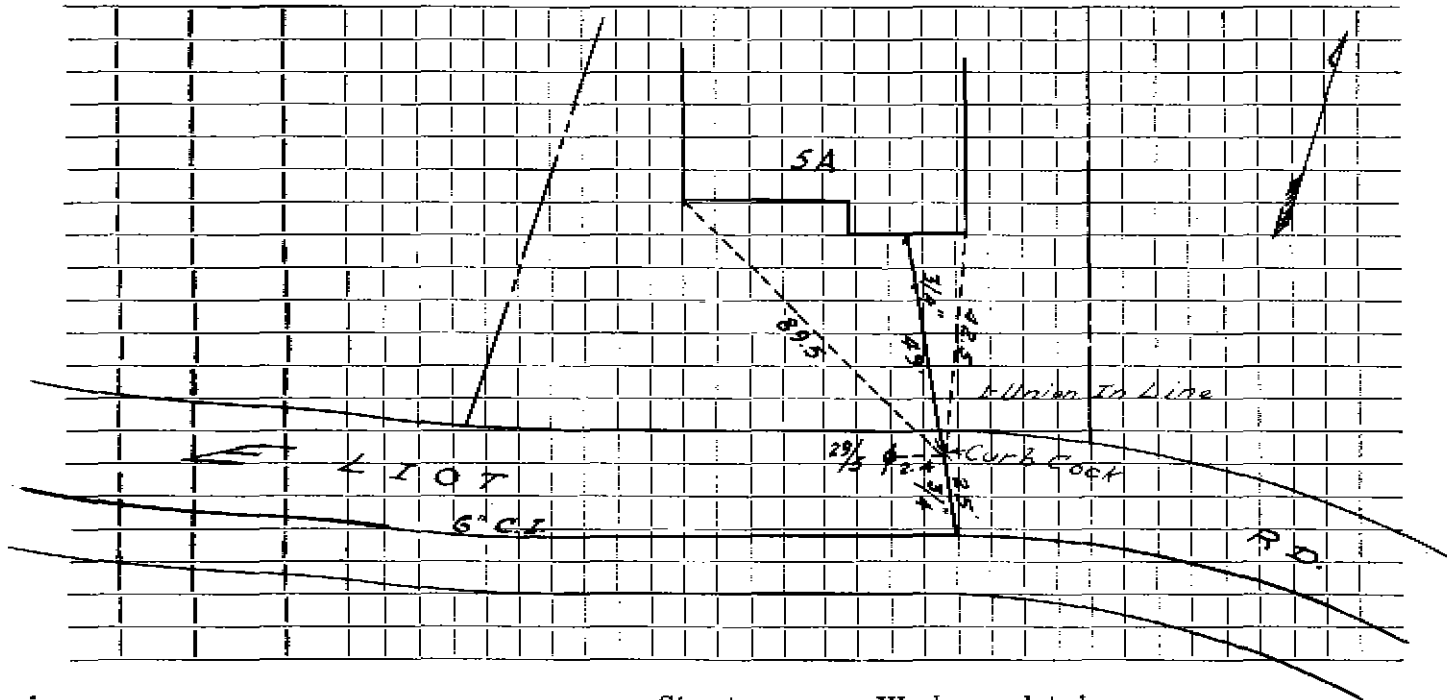

Connection made in \_\_\_\_\_ Street. Work completed \_\_\_\_\_

Remarks: \_\_\_\_\_  
\_\_\_\_\_  
\_\_\_\_\_