

WATER SERVICE RECORD

Name

Service No.

Address

7 Eliot Rd

Location

Repair—Renewal—New Service


Date	Material	Amount	Total	Date	Amount
7-13-48	64' 3/4" Copper			7/13/58	
	1 3/4 x 1/2 StW				25 3/4 copper
	1 3/4 3 part union				1 3/4 corp
					1 3/4 curb
					1 box seal wcl
					3

DATE _____

TOWN OF LEXINGTON — BOARD OF PUBLIC WORKS

WATER DIVISION

Sketch of Service Here

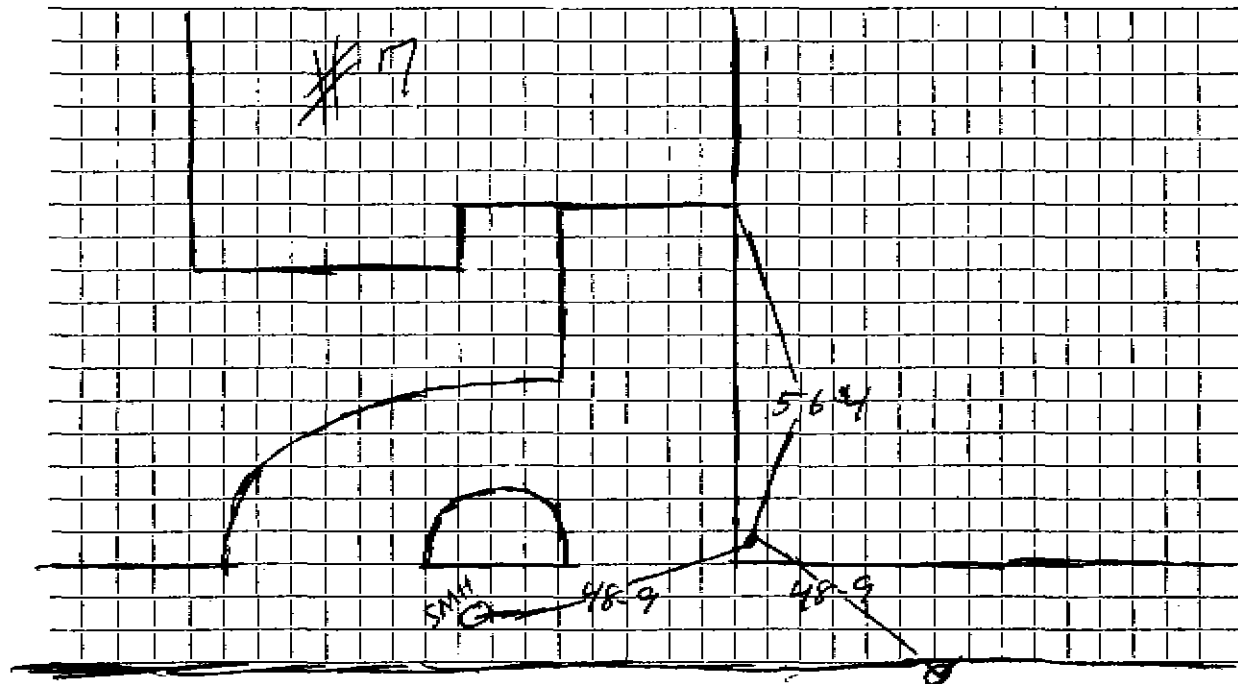

Connection made in Street. Work completed

Remarks:
.....
.....