

Name Elmer E. Lambert

Service No. 34 810

Address 6 Ellis Street, Lexington, Mass.

Location

Kind of Pipe

Size

Size of Main

~~Repair~~ ~~Renewal~~ New Service

Location

Date
1941

Material

Amount

Total

Date

Amount

May 21
Com 4/9/41

4 hrs. @ 60¢	2 40	
5 " @ 70¢	3 50	
10% Overhead		
165' 3/4" Copper tubing	19 00	
1 3/4" C.S. @ 25		
1 3/4" C. Union (3 part)		
1 3/4" C. x 1/2" I. Union		
trucking 4 hrs. @ 75¢		

4 90	
31 35	
2 25	
1 00	
1 00	
3 00	
43 99	

May 16, 1941 Deposited
June 19, 1941 Refunded

62 00
18 01
43 99

OUTSIDE W.O. 5905

11/15/77

Labor	143 70
18' 3/4 Copper @ .83	14 94
1 3/4 Curb	15 07
1 Box & Rod	13 41
2 Ton Cold Patch @ 13.50	27 00
2 Hrs. Trucking @ 3.00	6 00
2 Hrs. Backhoe @ 6.50	13 00

233 12

Labor

Hadley Press, Inc., Lexington

DATE _____

TOWN OF LEXINGTON—BOARD OF PUBLIC WORKS WATER DIVISION

The undersigned applies for a supply of water at No. _____ St. and hereby agrees to comply with the rules and regulations as now, or at any future time, established by the Board of Selectmen.

Am't. of Estimate \$ _____


Owner _____

Am't. Paid \$ _____

Address _____

Builder _____

Sketch of Service Here

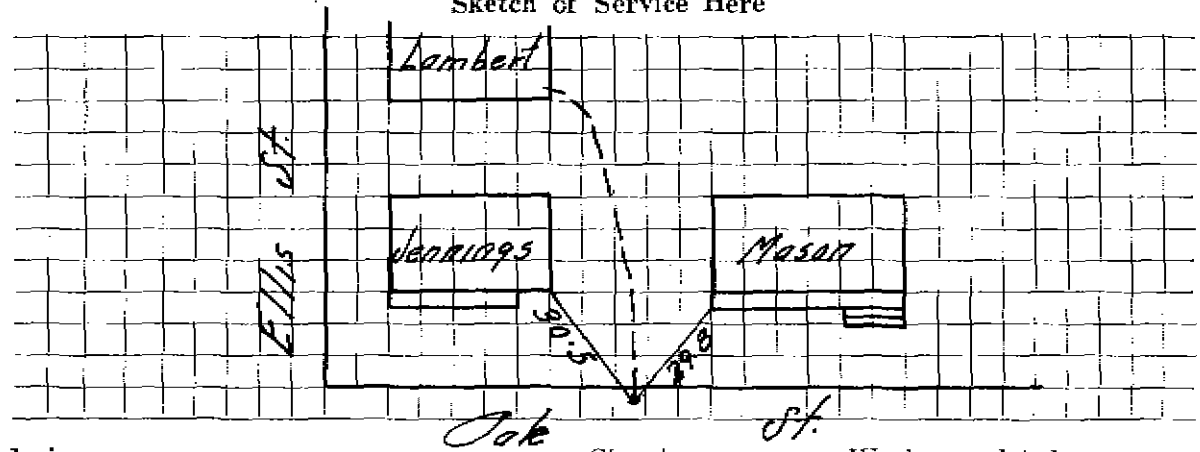

Connection made in _____ Street.

Work completed _____ 19__

Remarks: