

Name Gustave Larson

Service No.

#6716

Address 7 Ellis Street

#179

Lexington, Mass.

Location 7 Ellis Street

Kind of Pipe

Size

Size of Main

~~REPAIR~~ ~~REPAIR~~ - New Service

Com. 6-15-49

Location

Date	Material	Amount	Total	Date		Amount
Apr. 27, '49	Labor	4 70	4 70	April 20/49	Deposited	20 00
	10% Overhead		47	July 15 '49	paid	1 85
	32' - 3/4" Copper Tubing @.27		8 64		Non-Charge	31 85
	1 - 3/4" C x 1/2" I.W.H. S&W		3 29	Apr. 27, '49	Labor	3 50
	Littlefield Shovel 2 hrs. @7.00	14 00	14 00	28	"	1 20
	Trucking 1 hr. @.75		75	29	"	3 60
			31 85	26' - 3/4" Copper Tubing @.27		7 02
				1 - 3/4" Corp-cock		3 15
				1 - 3/4" C x 3/4" C curb-cock		3 85
				1 - 3/4" C x 3/4" C Union (3 pts)		1 39
				1 - Box & Rod		3 95
				1 - 1/2" Offset Tail Piece		37
	Labor			1 - 1/2" Straight Tail Piece		37
				Littlefield Shovel 5 hrs. @ 7.00		35 00
				Trucking 1 hr. @.75		75
						64 15

DATE _____

TOWN OF LEXINGTON - BOARD OF PUBLIC WORKS

WATER DIVISION

The undersigned applies for a supply of water at No..... St. and hereby agrees to comply with the rules and regulations as now, or at any future time, established by the Board of Selectmen.

Am't of Estimate \$.....

Owner


Am't Paid \$.....

Address

Builder

.....

Sketch of Service Here

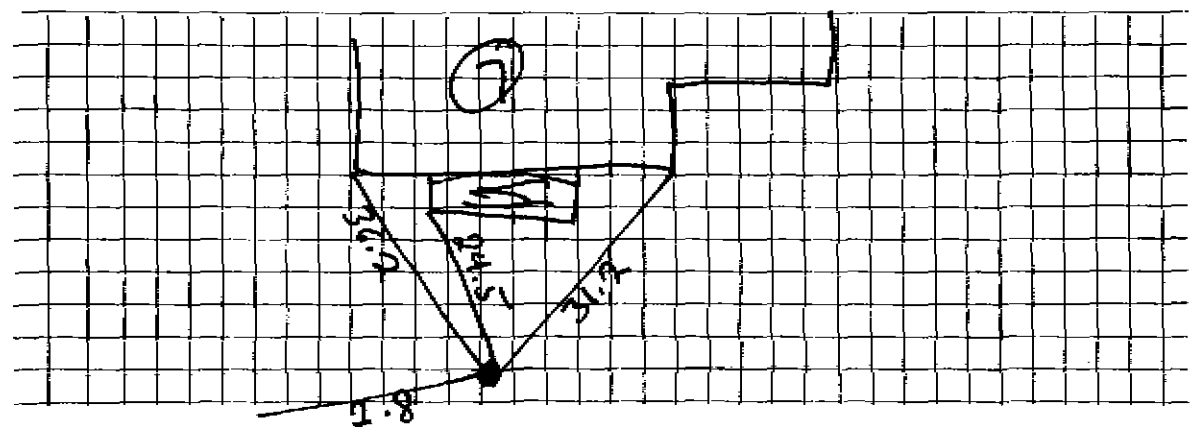

Connection made in Street.

Work completed19

Remarks: