

WATER SERVICE RECORD

1055

Service No. 307

Name Bob Innis

Address 10 Ellison Road

Location Lexington

~~Repair~~ ~~Reconnect~~ New Service COM. 12-8-52


Date	Material	Amount	Total	Date	Material	Amount
11/12/52	Labor	1 63		11-7-52	Appraised	45
	10% overhead	16	1 79	12-8-52	Refused	(26 90)
	34' -3/4" copper tubing@.34	11 56			NON CHARGE	18 10
	1 -3/4"C x 1/2 I.W.H. stop& waste	4 00		11/12/52	Labor	4 17
	1 hr. trucking		75		16' -3/4" copper tubing@.34	5 44
			18 10		1 -3/4"C corp-cock	4 33
	TRENCH DUG BY OWNER				1 -3/4"C x 3/4"C curb-cock	4 67
					1 box and rod	3 90
					1 -1/2 offset tail pc.	50
					1 -1/2 straight tail pc.	50
					1 hr. trucking	75
						<u>24 26</u>

DATE _____

TOWN OF LEXINGTON — BOARD OF PUBLIC WORKS

WATER DIVISION

Sketch of Service Here

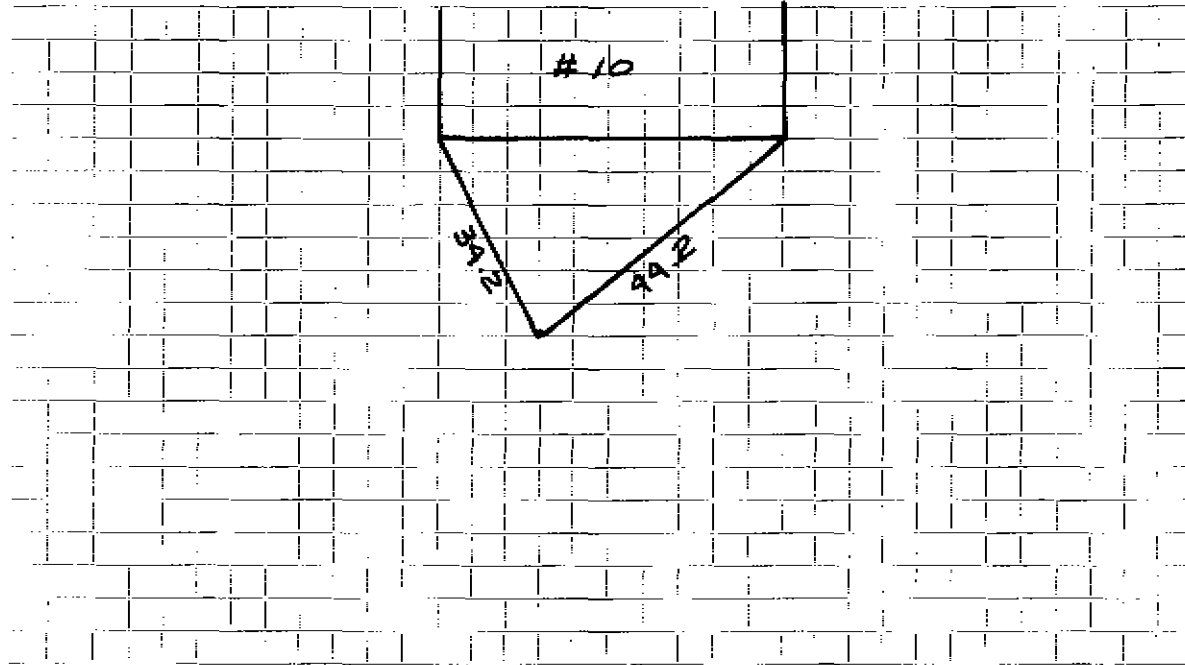

Connection made in Street. Work completed

Remarks:

.....

.....