

WATER SERVICE RECORD

Name Leeland Construction Co., Inc.

Service No. 59

Address 11 Ellison Road

Location

~~Repair~~ ~~Renewal~~ - New Service

Com 6-1-54


Date	Material	Amount	Total	Date	Amount
5/12/54	Labor	1 85		3-31-54 Deposited	23 00
	10% overhead	19	2 04	6-1-54 Refunded	4 21
	40' 3/4" Copper tubing @ .35	14 00			20 79
	1 - 3/4" Cx 1/2" I.W.H. stop & waste	4 00		5/12/54 Labor	5 05
	1 hr. trucking		75	25' 3/4" Copper tubing @ .35	8 75
			20 79	1 - 3/4" C. Corp-cock	4 33
				1 - 3/4" Cx 3/4" C. curb-cock	4 67
				1 Box & Rod	3 90
				1 - 1/2" straight tail piece	50
				1 - 1/2" offset tail piece	50
				1 hr. trucking	75
	TRENCH DUG BY OWNER				28 45

DATE _____

TOWN OF LEXINGTON — BOARD OF PUBLIC WORKS

WATER DIVISION

Sketch of Service Here

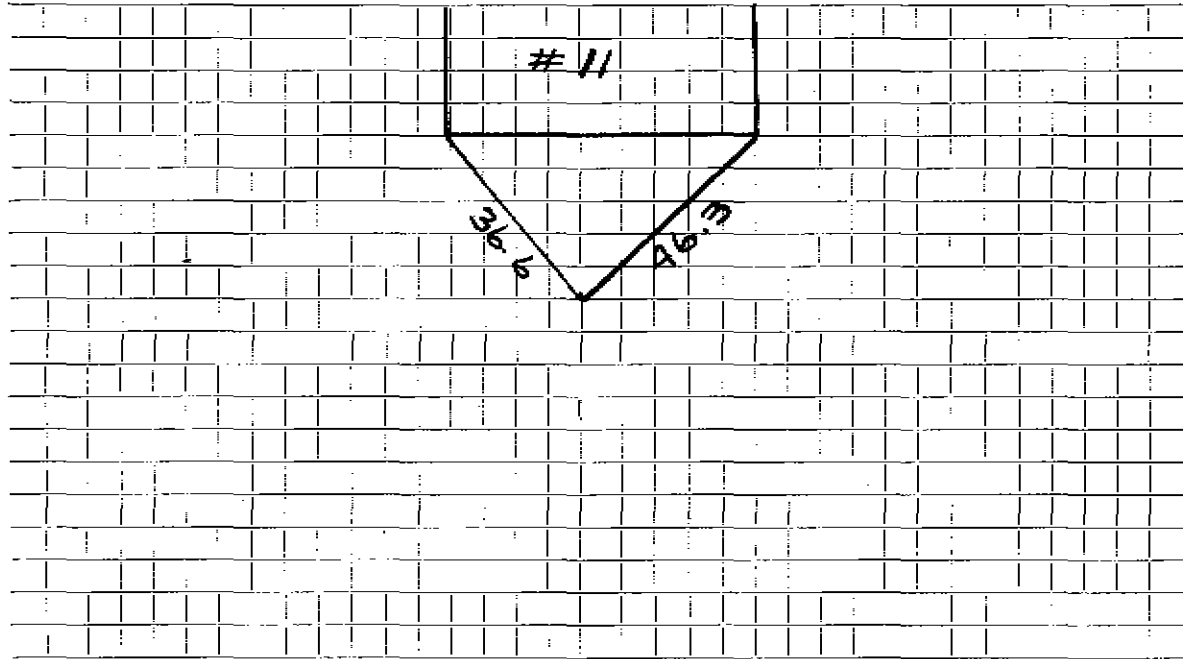

Connection made in Street. Work completed

Remarks:
.....
.....