

WATER SERVICE RECORD

Name Leeland Construction Co., Inc.

Service No. 60

Address 12 Ellison Road

1802

Location

~~Repair/Reconnect~~ - New Service

Com. 6-1-54


Date	Material	Amount	Total	Date	Amount
4/27/54	Labor	1 85		5-31-54 Deposited	25 00
	10% Overhead	19	2 04	6-1-54 Refunded	4 91
	38'-3/4" Copper Tubing @ .35		13 30	<u>NON CHARGE</u>	20 09
	1 - 3/4" C x 1/2" I.W.H. stop & waste	4 00	4 00	4/27/54 Labor	7 83
	1 hr. trucking		75	12' - 3/4" Copper tubing @ .35	4 20
			20 09	1 - 3/4" C. curb-cock	4 33
				1 - 3/4" C x 3/4" C. Curb-cock	4 67
	TRENCH DUG BY OWNER			1 box and rod	3 90
				1 - 1/2" straight tail piece	50
				1 - 1/2" offset tail piece	50
				1 hr. trucking	75
					26 68

DATE _____

TOWN OF LEXINGTON — BOARD OF PUBLIC WORKS

WATER DIVISION

Sketch of Service Here

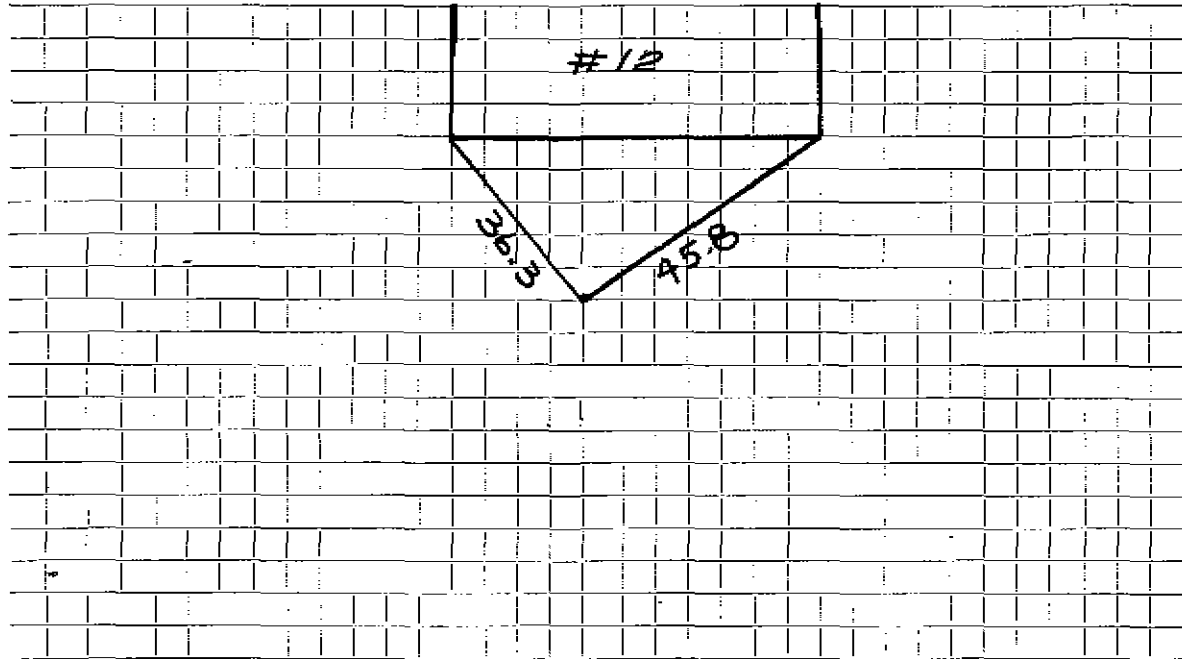

Connection made in Street. Work completed

Remarks:
.....
.....