

5666

WATER SERVICE RECORD

Service No. 61

Name Leeland Construction Company

Address 11 Ellison Road

Location

~~Repair~~ Renewal - New Service

com. 5-3-54

Date	Material	Amount	Total	Date	Amount
4/13/54	Labor	1 85		3-31-54 Deposited	25 00
	10% overhead	19	2 04	5-3-54 Refunded	(2 46)
	15'-3/4" Copper tubing @.35	15 75			NOV CHARGE
	1-3/4" Cx 1/2" I.W.H. Stop & waste	4 00		4/13/54 Labor	1 85
	1 hr trucking		75	10'-3/4" Copper tubing @.35	3 50
			22 54	1-3/4" C. Comp cock	1 33
				1-3/4" 3 x 3/4" C curb cock	4 57
				1 Box # rod	3 90
				1-3/4 Straight tail piece	50
				1-3/4 Offset tail piece	50
				1 hr trucking	75
					20 00


TRENCH DUG BY OWNER:

DATE _____

TOWN OF LEXINGTON — BOARD OF PUBLIC WORKS

WATER DIVISION

Sketch of Service Here

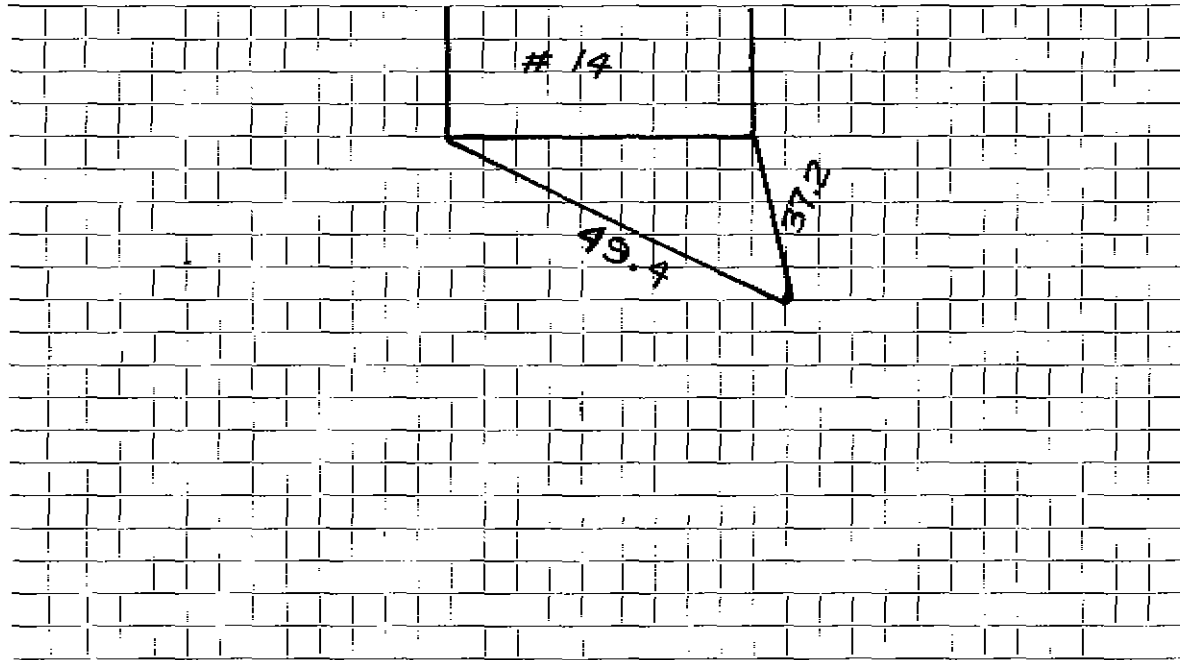

Connection made in Street. Work completed

Remarks:
.....
.....