

WATER SERVICE RECORD

Name Leeland Construction Co., Inc.

Service No. 62

Address 15 Ellison Road

Location

~~Repair - Renewal~~ - New Service

*Com. 6-1-54*


Date	Material	Amount	Total	Date	Amount
4/27/54	Labor	1 85		3-31-54	25 00
	10% Overhead	19	2 04	6-1-54	4 21
	40' - 3/4" Copper Tubing @ .35	14 00			20 79
	1 - 3/4" C x 1/2" I.W. R stop & waste	4 00	4 00	4/27/54	Labor
	1 hr. trucking		75		5 10
			20 79	25' - 3/4" Copper tubing @ .35	8 75
				1 - 3/4" C. curb-cock	4 33
				1 - 3/4" C x 3/4" C. curb-cock	4 67
				1 box and rod	3 90
				1 - 1/2" straight tail piece	50
				1 - 1/2" offset tail piece	50
				1 hr. trucking	75
	TRENCH DUG BY OWNER				28 50

DATE \_\_\_\_\_

TOWN OF LEXINGTON — BOARD OF PUBLIC WORKS

WATER DIVISION

Sketch of Service Here

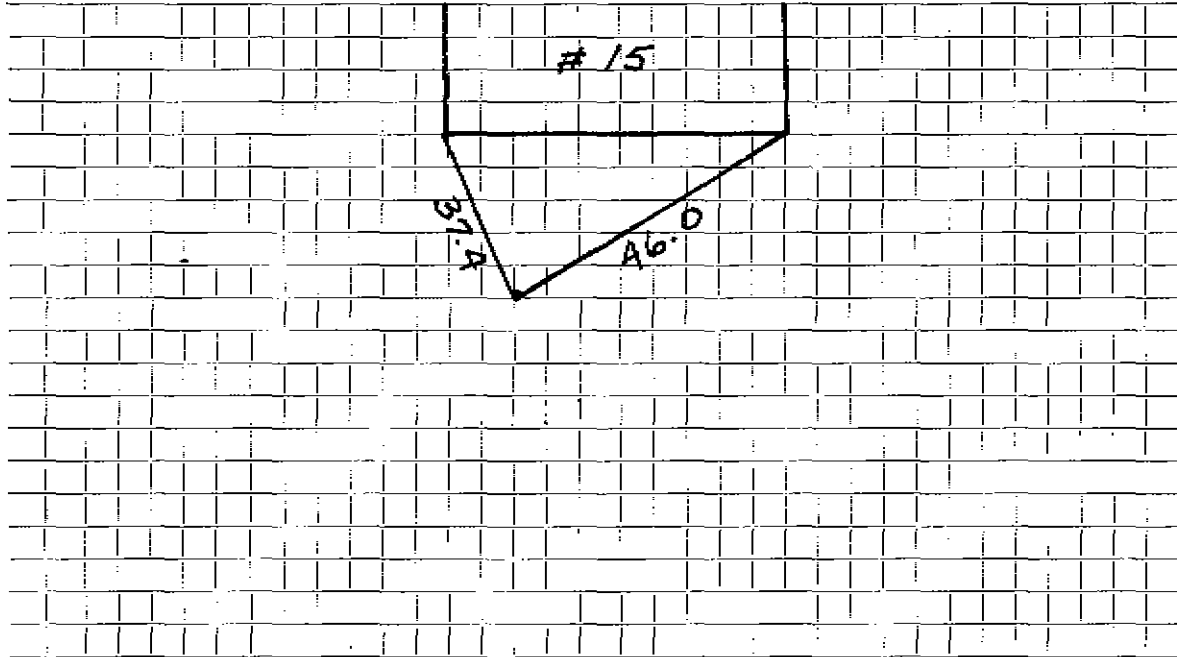

Connection made in ..... Street. Work completed .....

Remarks: .....

.....

.....